



LEHIGH VALLEY COAL CO.
WYOMING COLLIERY

LEHIGH VALLEY COAL CO.
PROSPECT COLLIERY

 

PETTEBONE COLLIERY, 1°100'...
• ABBOTT VEIN PLAINS TWP.,
LUZERNE COUNTY, WILKES-BARRE, PA.,
NORTHERN COAL FIELD...

LEHIGH VALLEY COAL CO.
DORRANCE COLLIERY

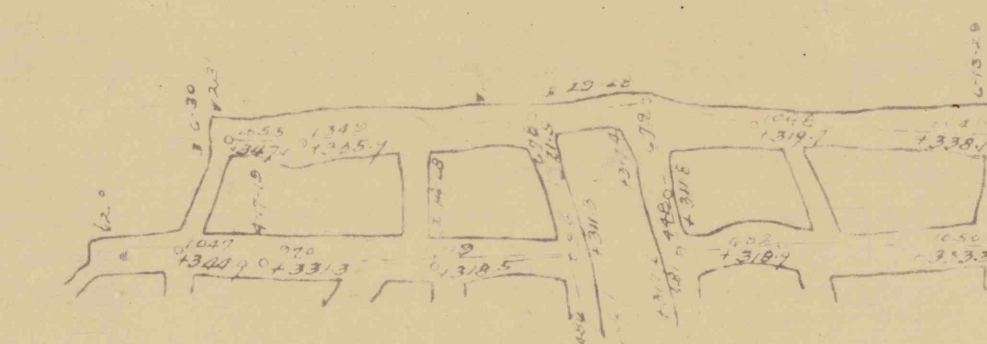

LEHIGH VALLEY COAL CO.
DORRANCE COLLIERY