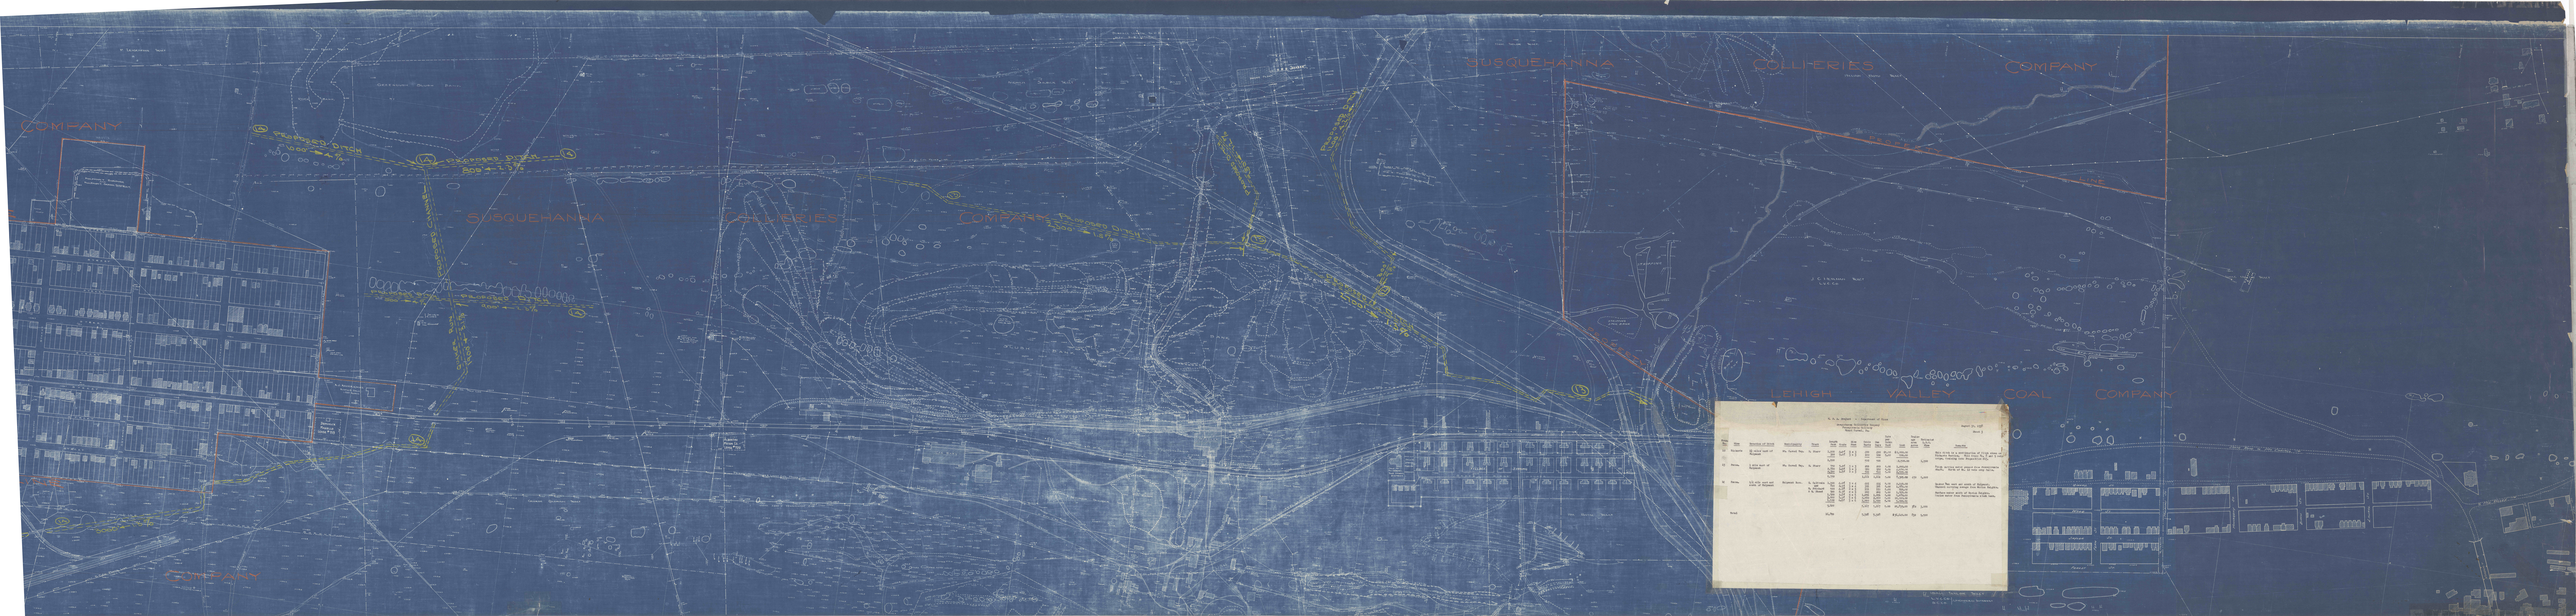


U. S. ENGRS. — Department of Navy

Susquehanna Anthracite District

Flood Control Plan

August 24, 1937

Sheet 2

