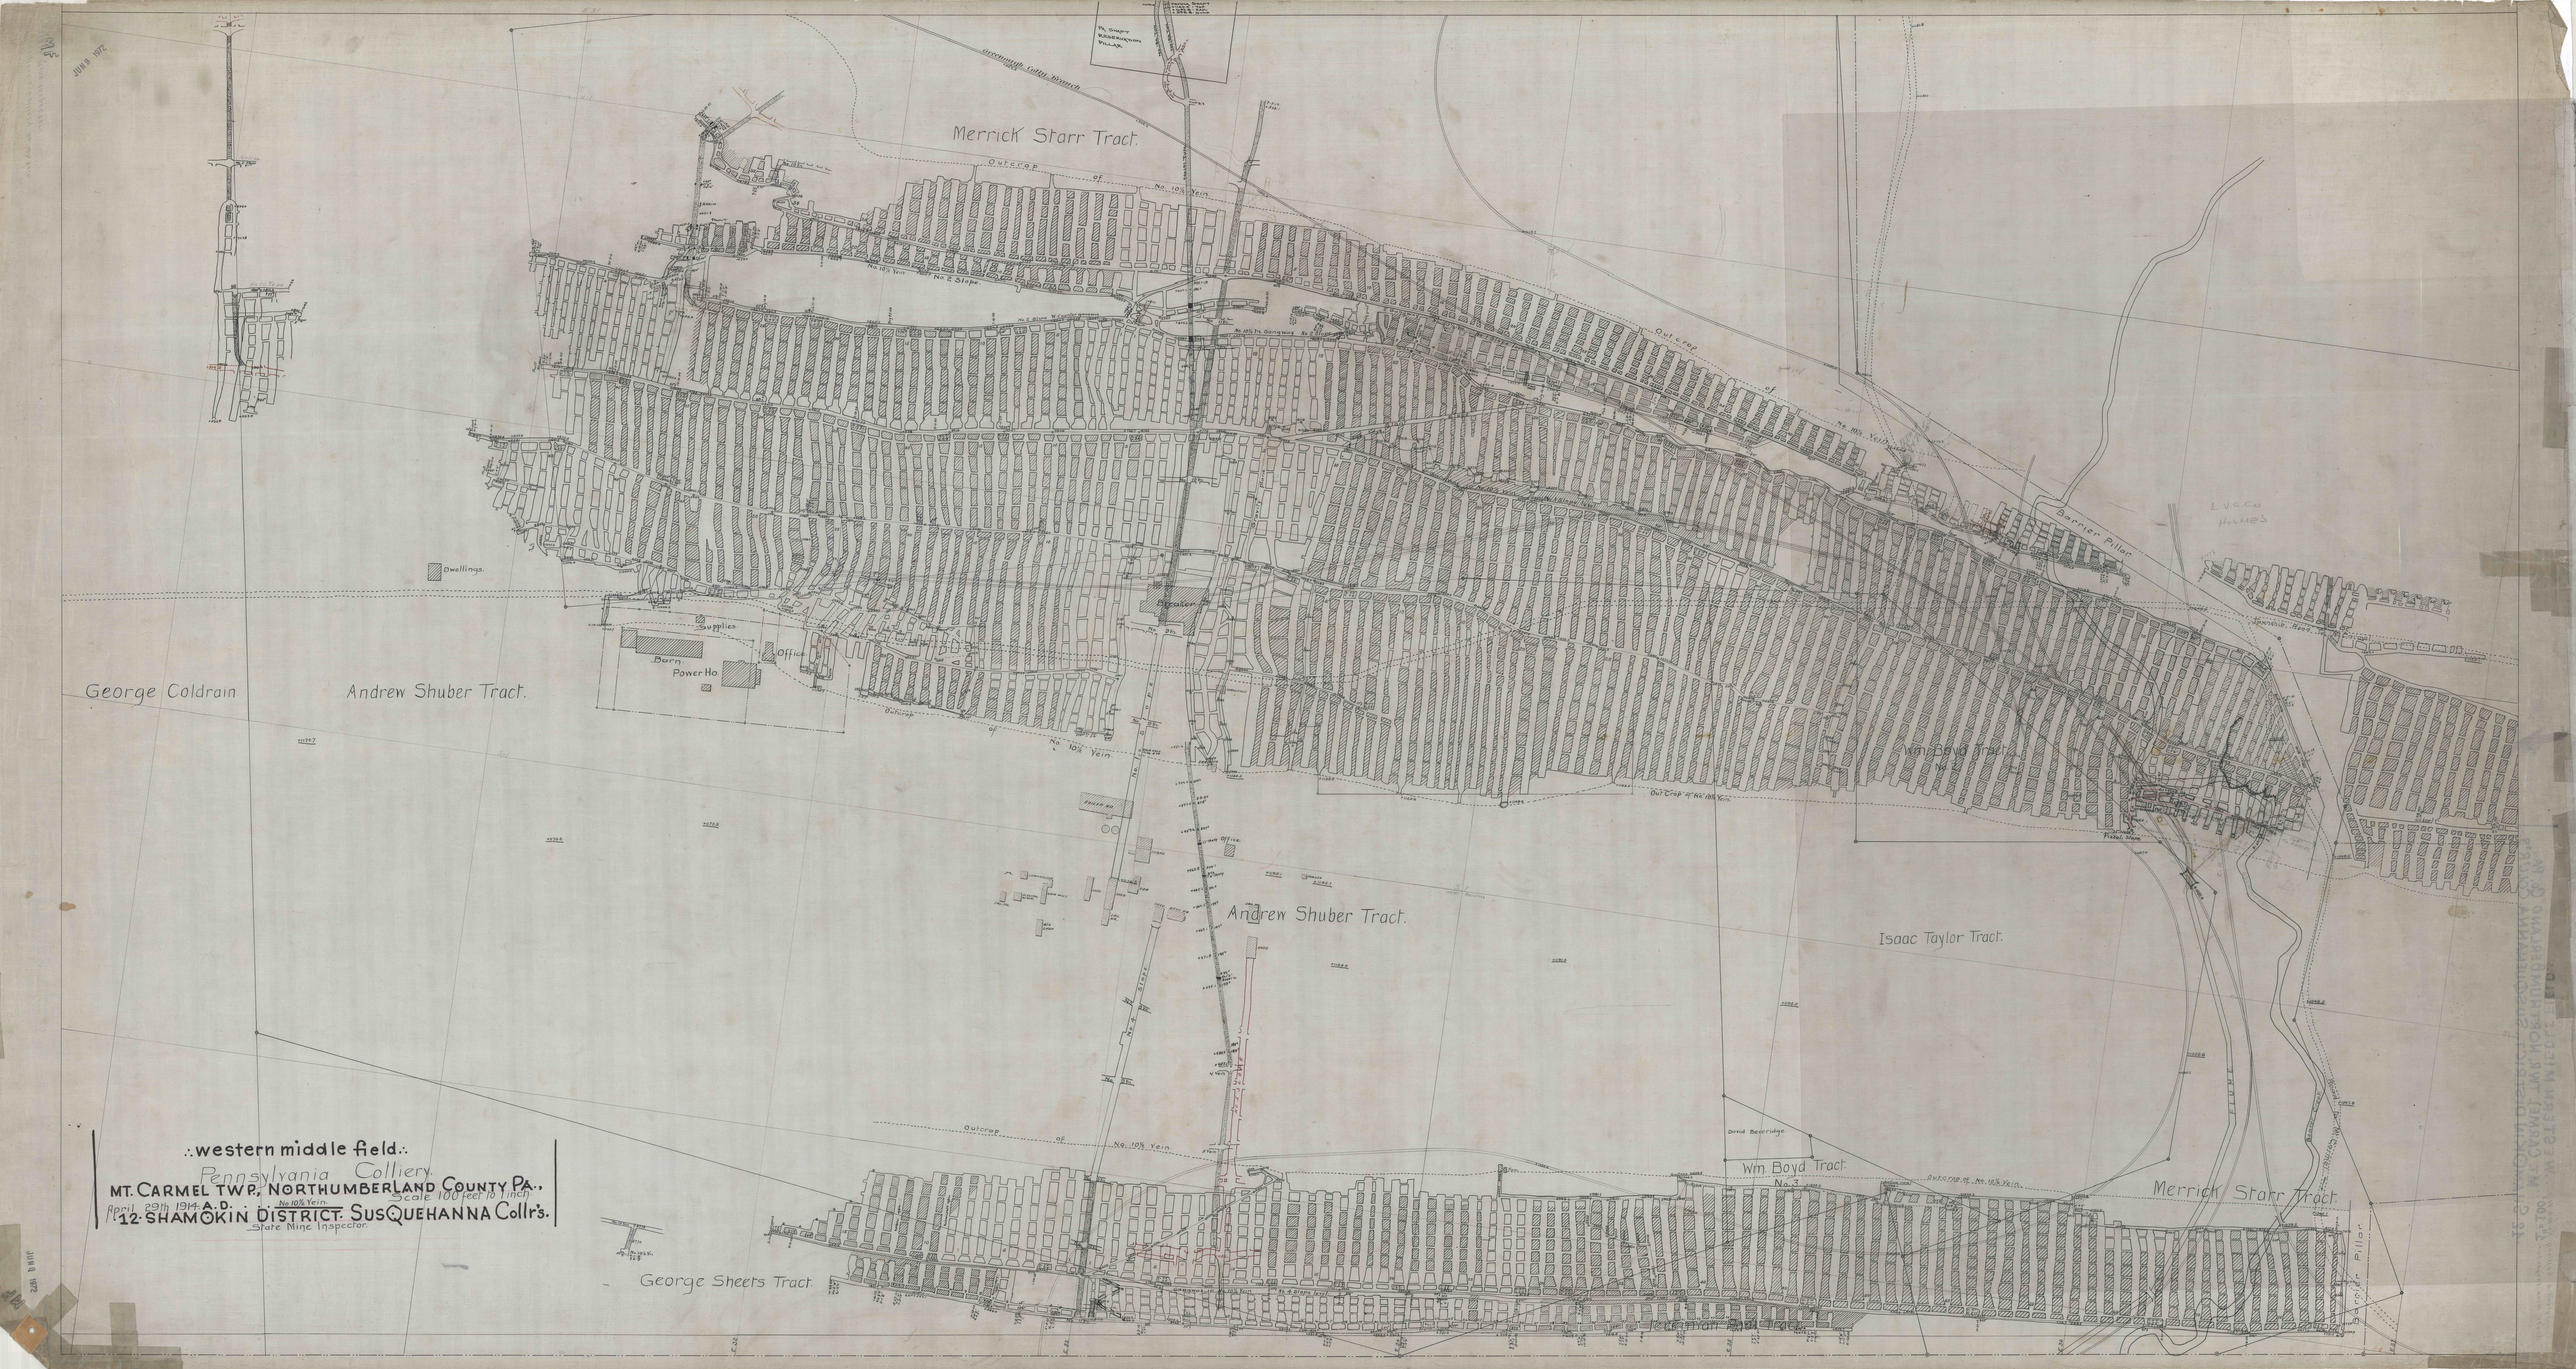

Merrick Starr Tract.
Outcrop of No. 10½ Vein.
No. 10½ Vein
No. 2 Slope
Barrier Pillar
Dwellings.
Supplies
Barn
Power Ho.
Office
Breaker
George Coldrain
Andrew Shuber Tract.
Outcrop of No. 10½ Vein.
Wm. Boyd Tract
No. 2
Out Crop of No. 10½ Vein
Andrew Shuber Tract.
Isaac Taylor Tract.
Outcrop of No. 10½ Vein
David Beveridge
Wm Boyd Tract.
No. 3
Out Crop of No. 10½ Vein.
Merrick Starr Tract.
George Sheets Tract.
Barrier Pillar

.·.western middle field.·.

Pennsylvania Colliery.

MT. CARMEL TWP., NORTHUMBERLAND COUNTY PA.,

Scale 100 feet to 1 inch.

April 29th 1914. A.D. . . . No. 10½ Vein.

12·SHAMOKIN DISTRICT· SUSQUEHANNA Collr's.

State Mine Inspector.

JUN 9 1972