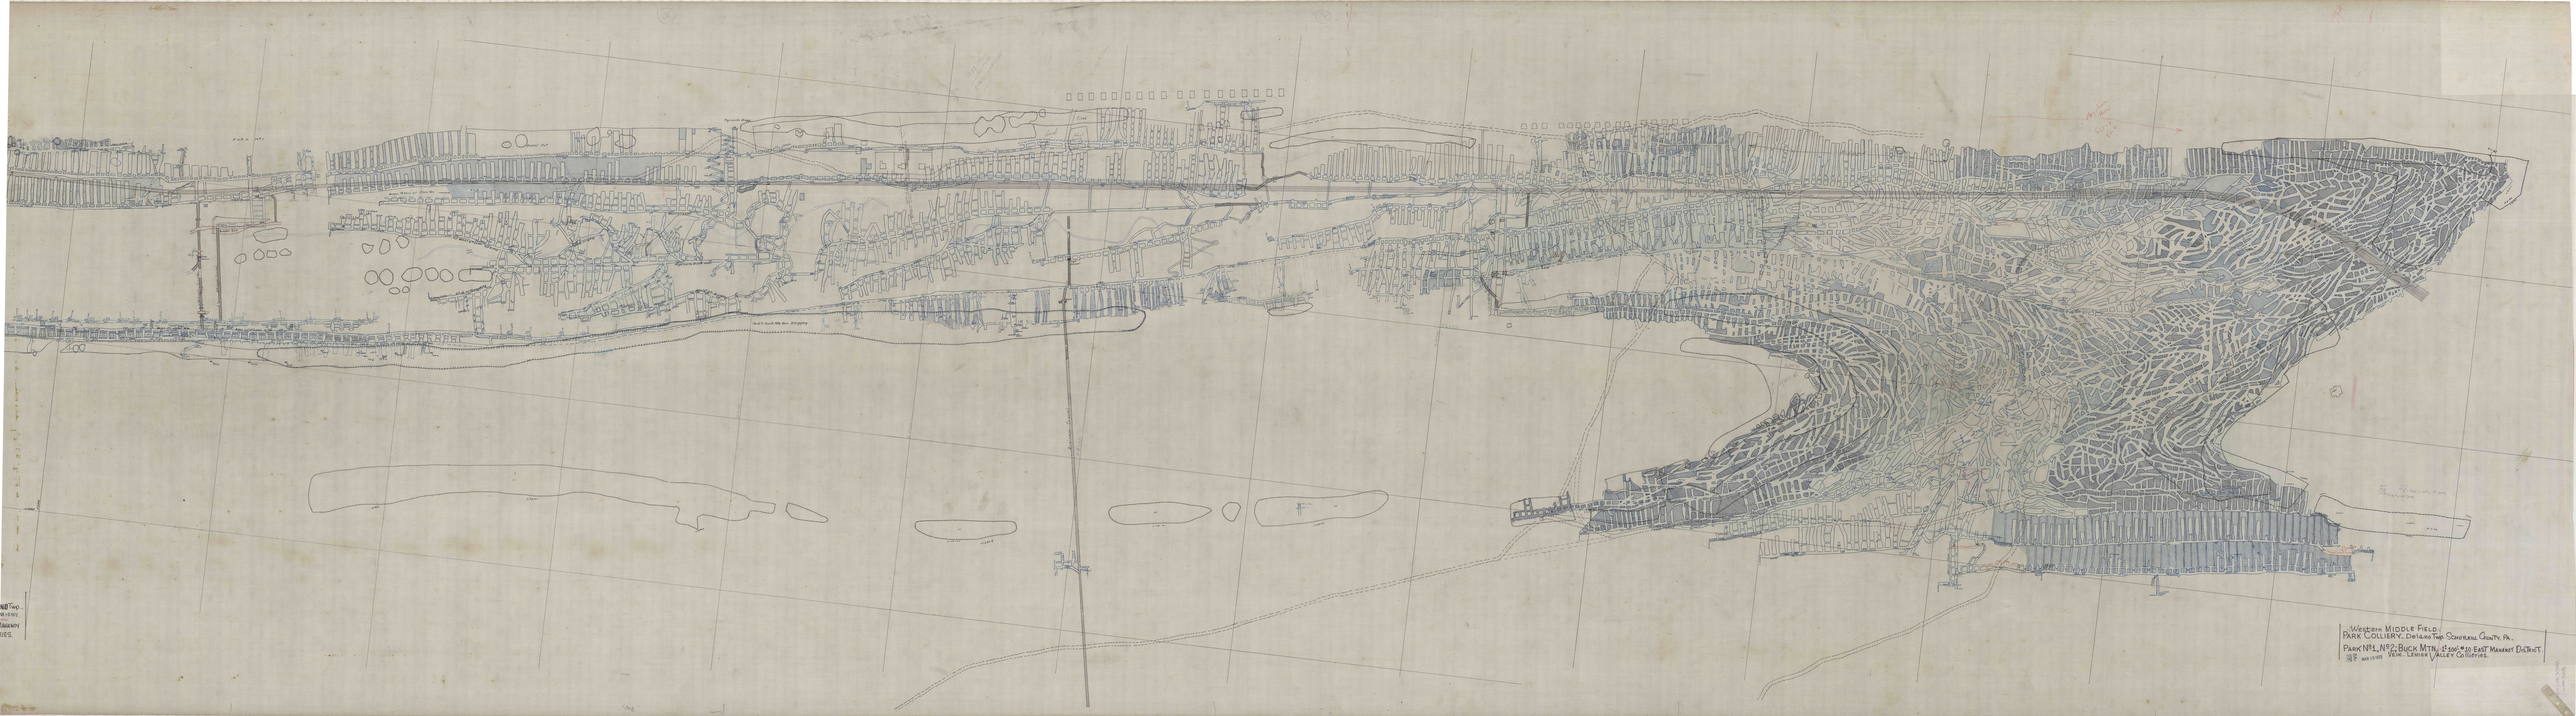
Western Middle Field.
Park Colliery. Delano Twp. Schuylkill County, Pa.
Park No1, No2, Buck Mtn. 1st 200 & 2d East Mammoth District.
Scale 1 in. = 100 ft. From Lehigh Valley Coal Office.