
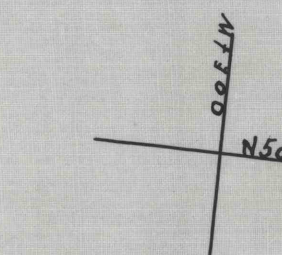


CORNER DETAIL TO BE SUBMITTED BY THE MINER CONCERNED
WESTERN MIDDLE FIELD

P & R. C. & I. CO.
L. V. CO. CO.

MF
MAR 10 1972

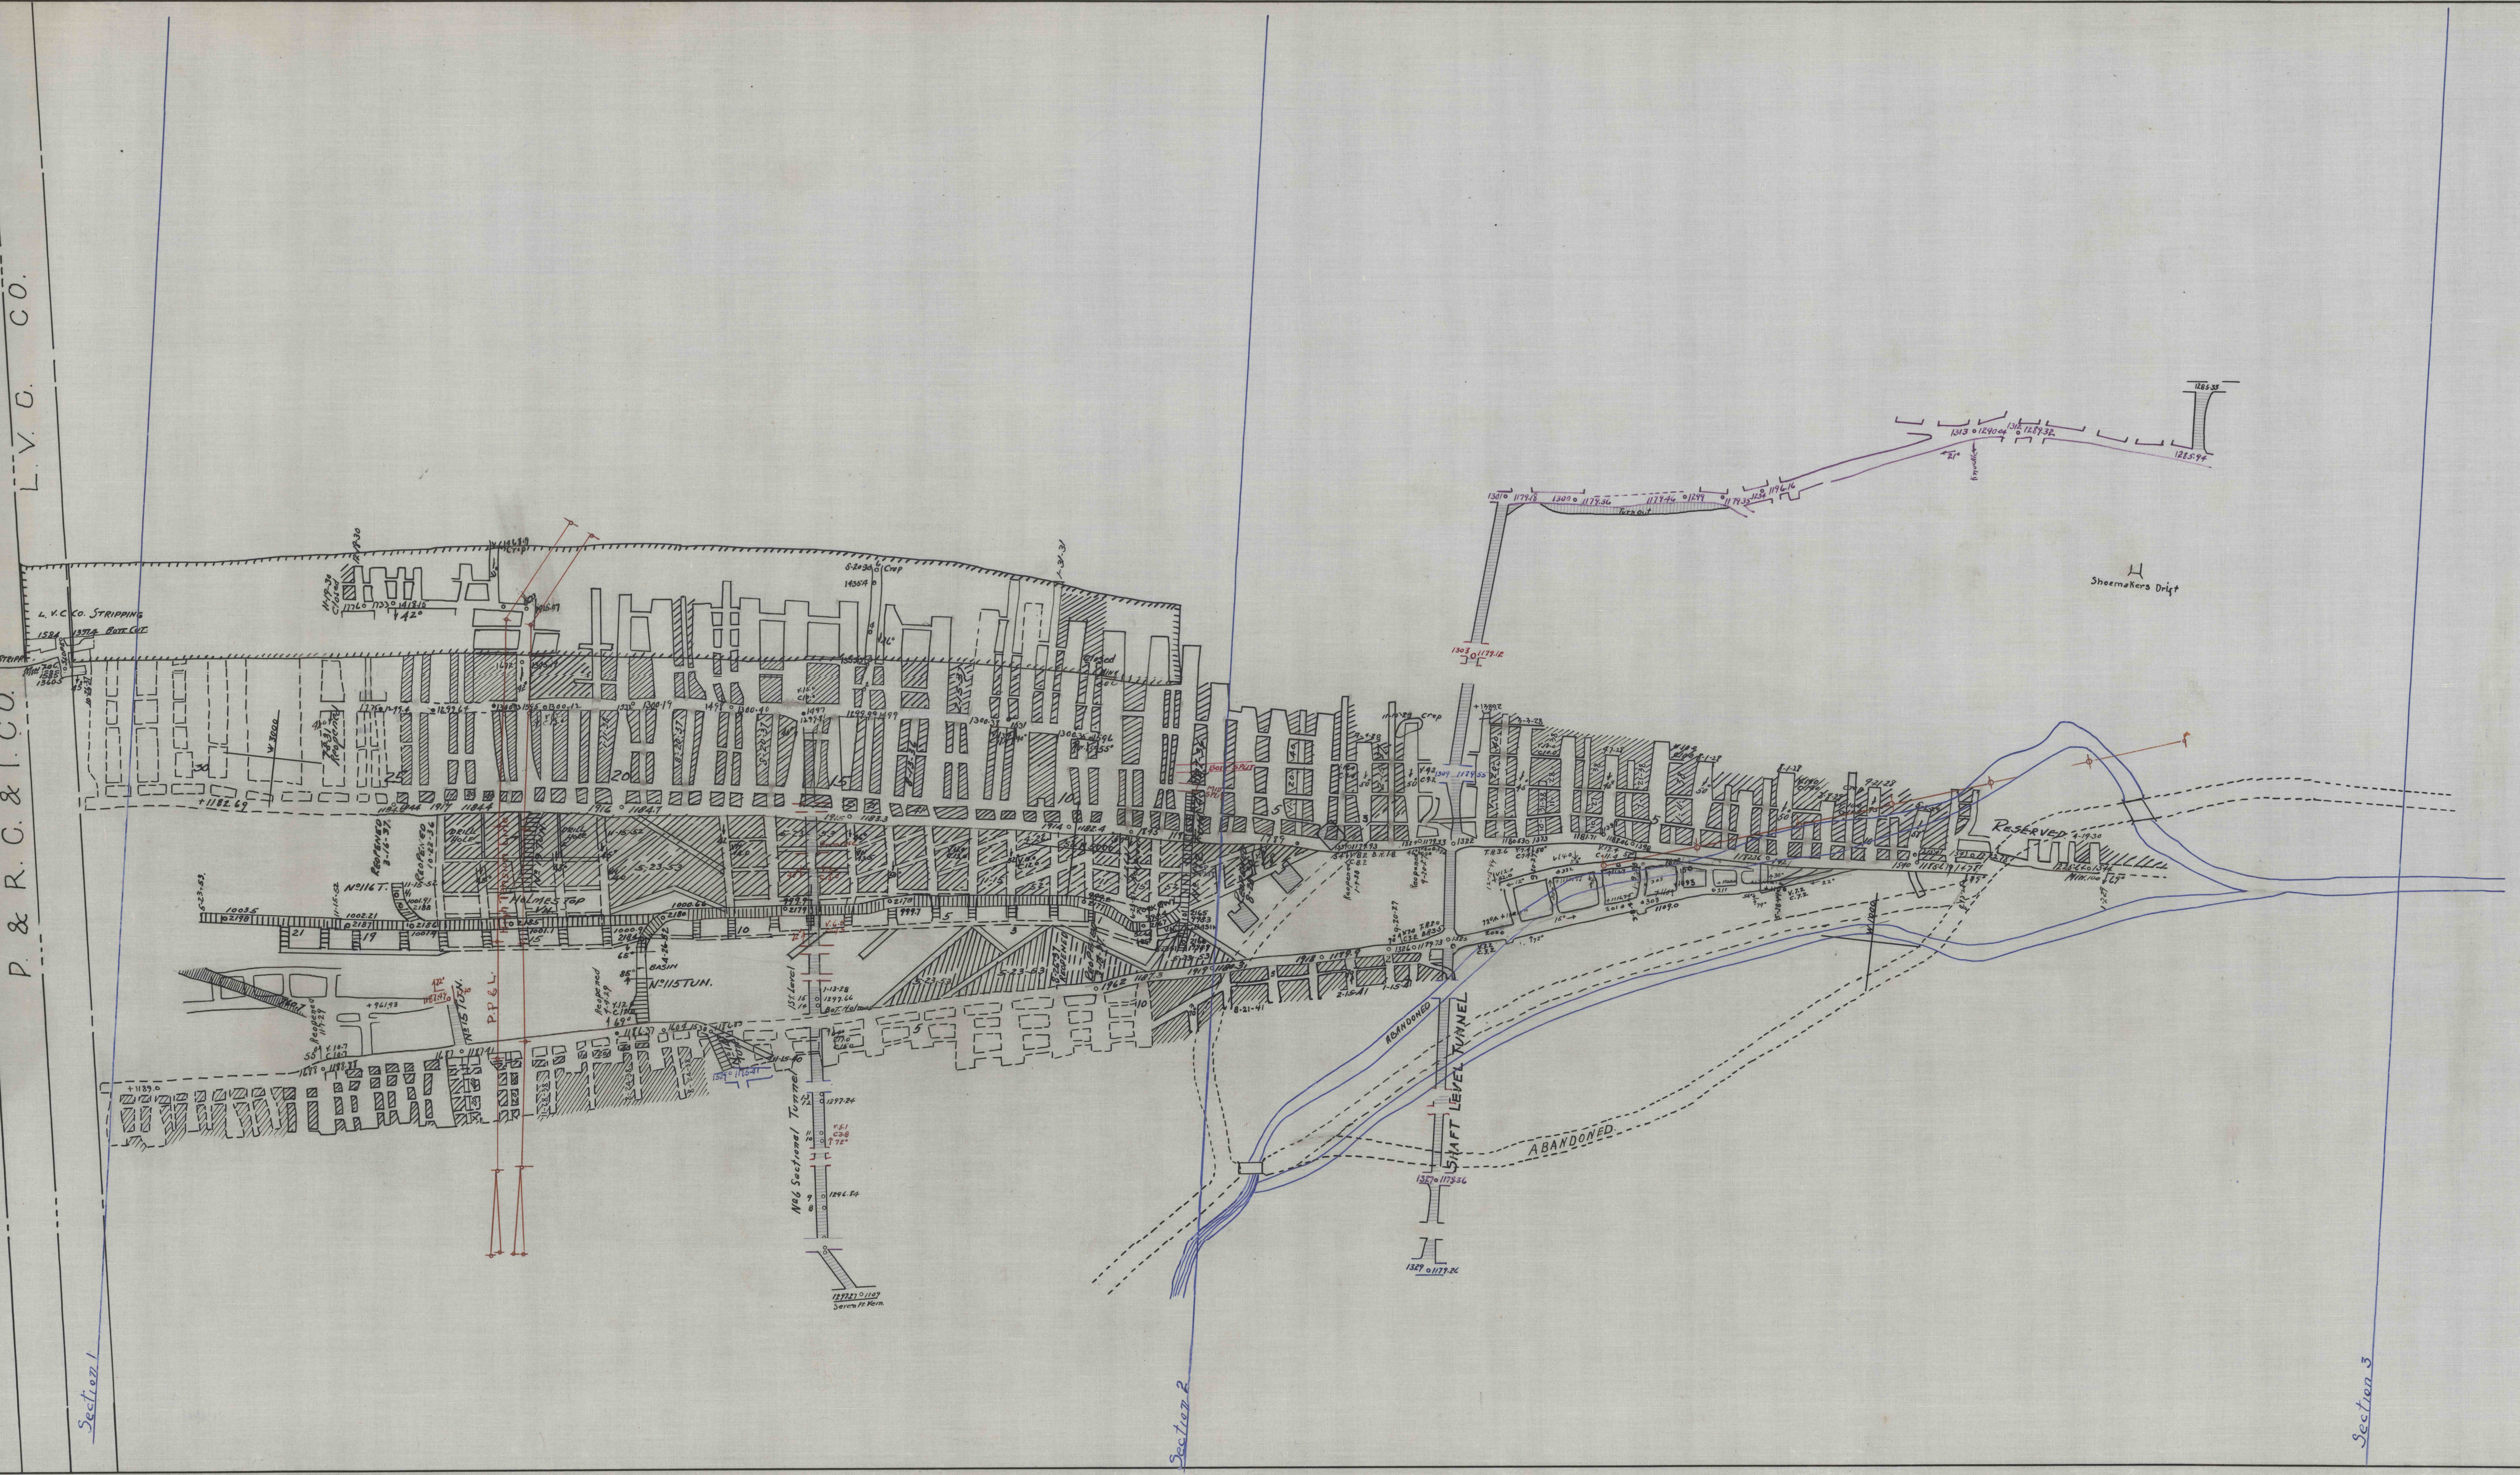

WESTERN MIDDLE FIELD
HOLMES BOTTOM SPLIT VEIN
PARK NO. 1 SLOPE
COLLIERY
DEAN TWP. SCHUYLKILL CO. PA.
#10 E. MAHANOEY DISTRICT L. V. CO.
MAR 10 1972
MF
MAR 10 1972
MAR 10 1972