


CONT. N
DARK NO. 1 SLOPE - BELLEVILLE No. 10 E. MAHANOA DIST.
WESTERN MIDDLE FIELD DELAND TWP. SCHUYLKILL CO. PA.

Scale

BARRIER PILLAR

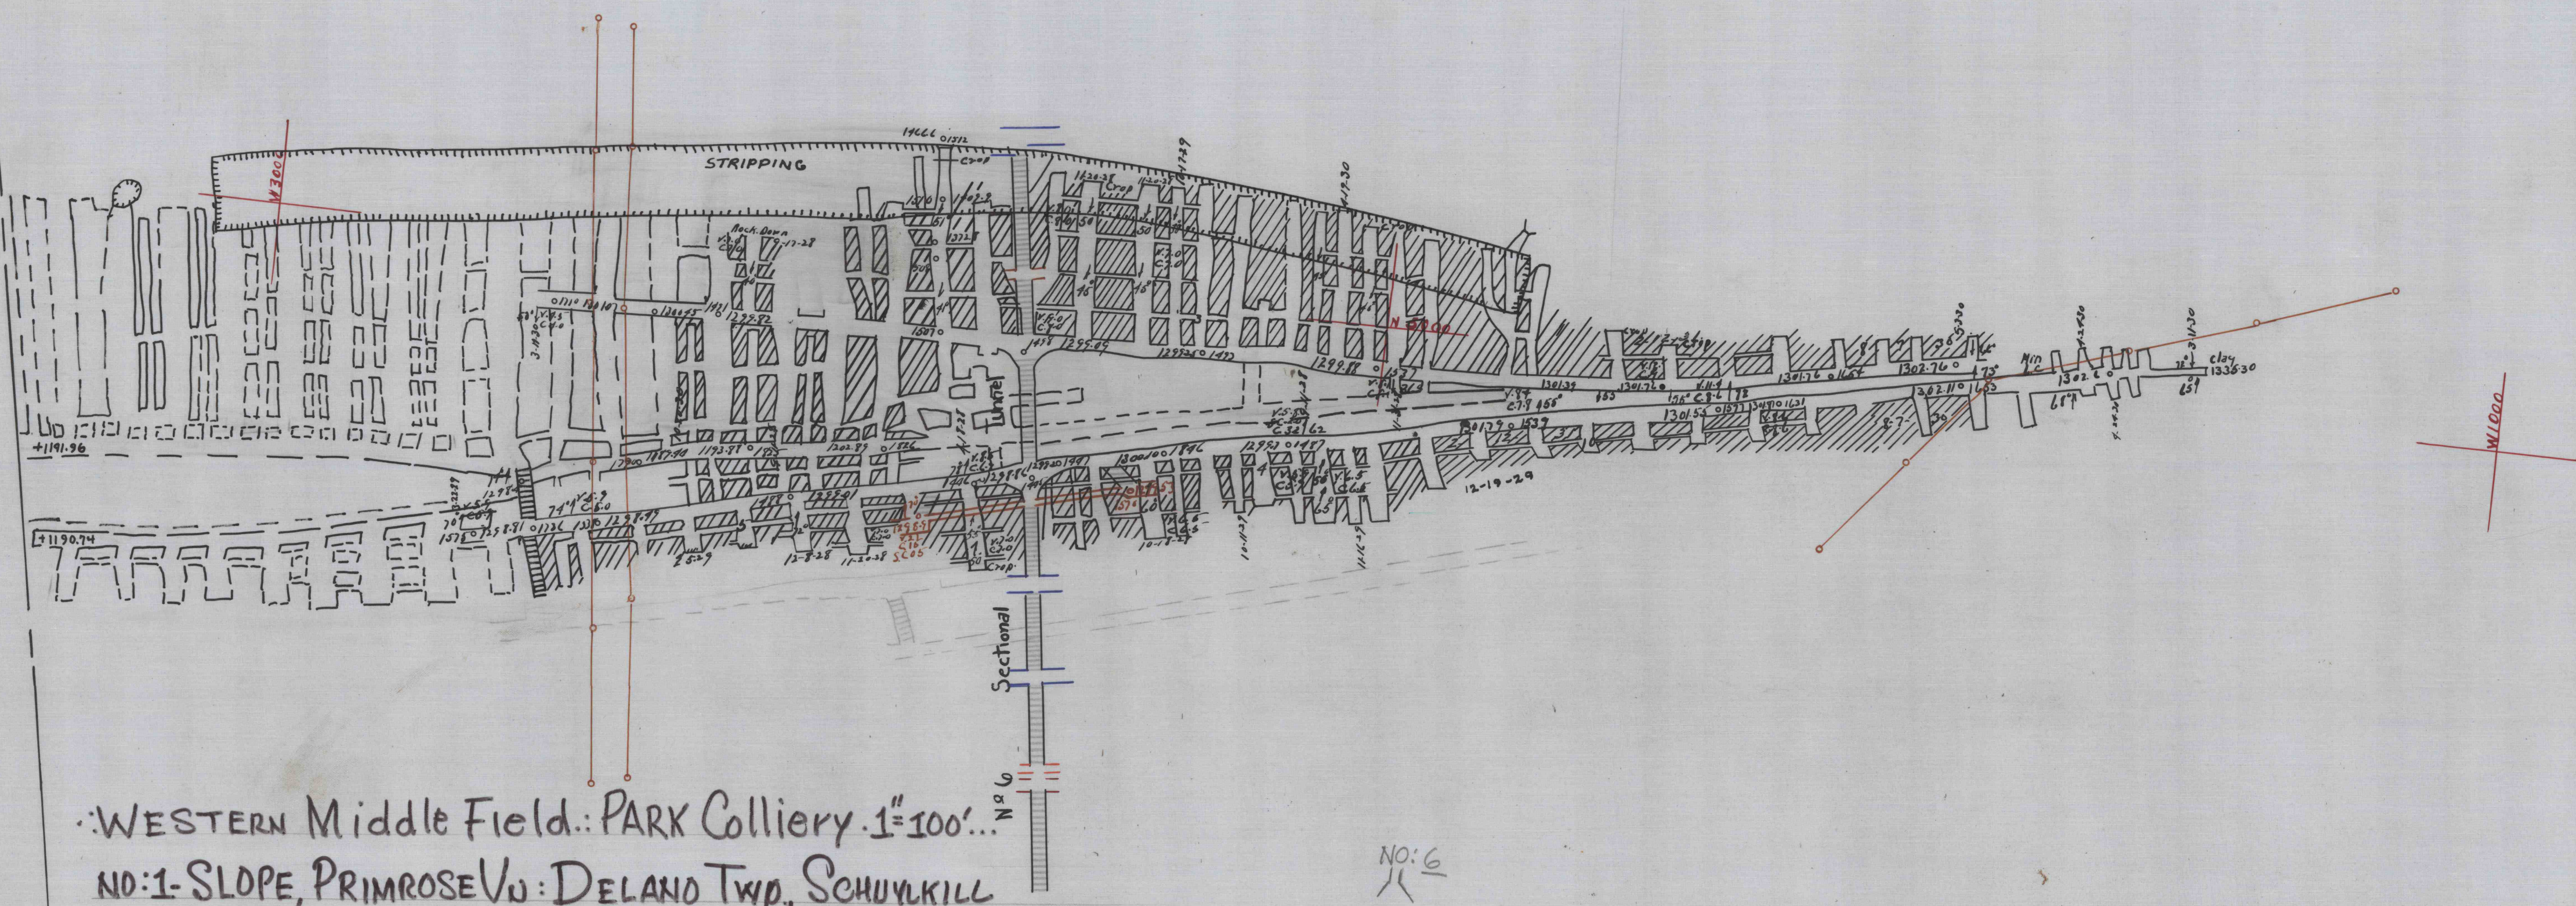

WESTERN MIDDLE FIELD: PARK Colliery. 1"=100'
NO: 1- SLOPE, PRIMROSE V. DELAND TWP. SCHUYLKILL
COUNTY. PA. # 10- EAST MAHANOA DISTRICT.
.. LEHIGH VALLEY COLLIERIES..

NO: 6

Primrose Vein.
Park No 1 Slope.

MF
MAR 10 1912