


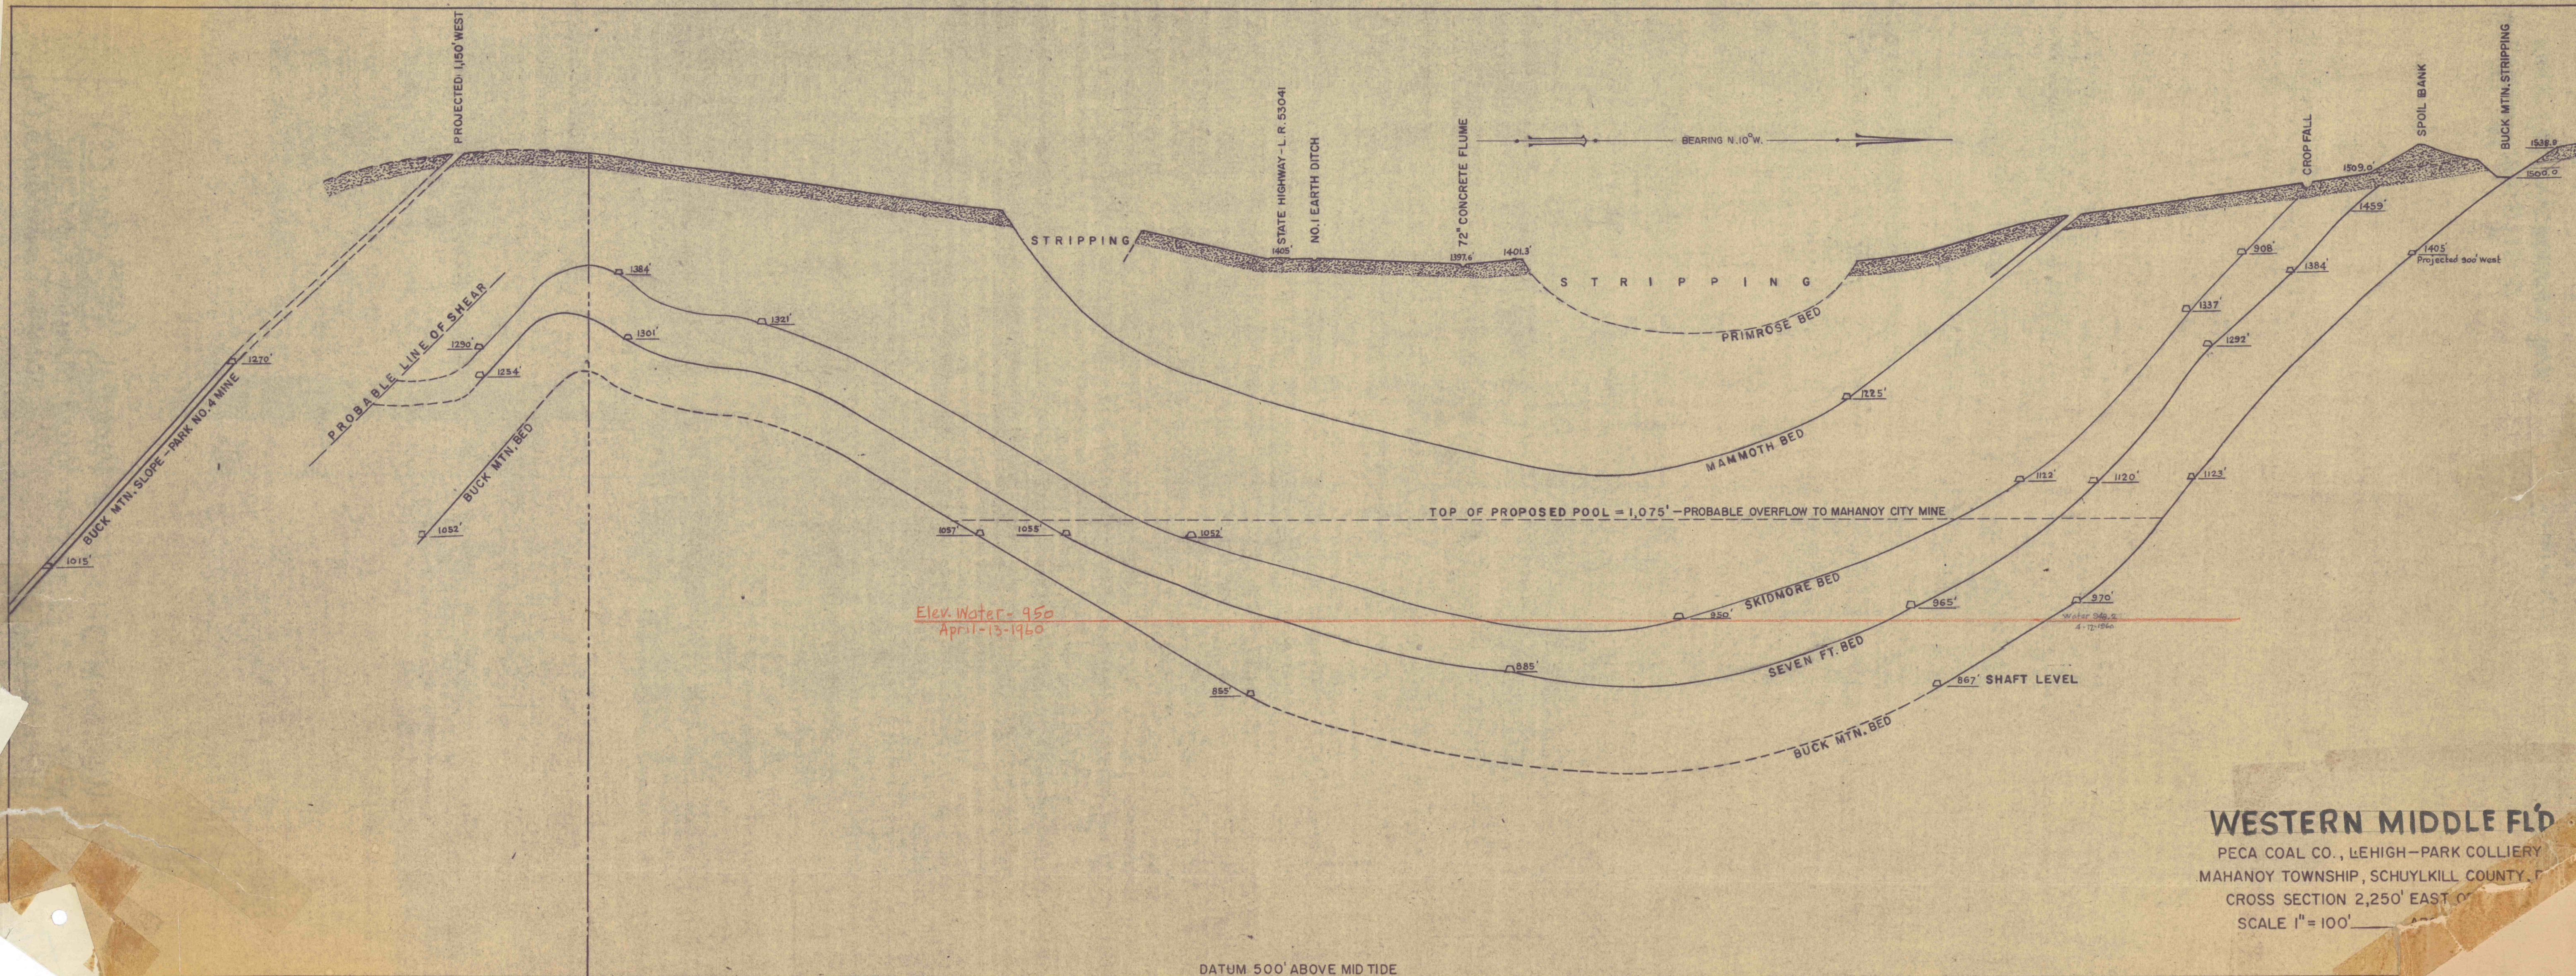

WESTERN MIDDLE FLÖ

PECA COAL CO., LEHIGH-PARK COLLIERY
 MAHANOEY TOWNSHIP, SCHUYLKILL COUNTY, PA.
 CROSS SECTION 2,250' EAST OF
 SCALE 1" = 100'