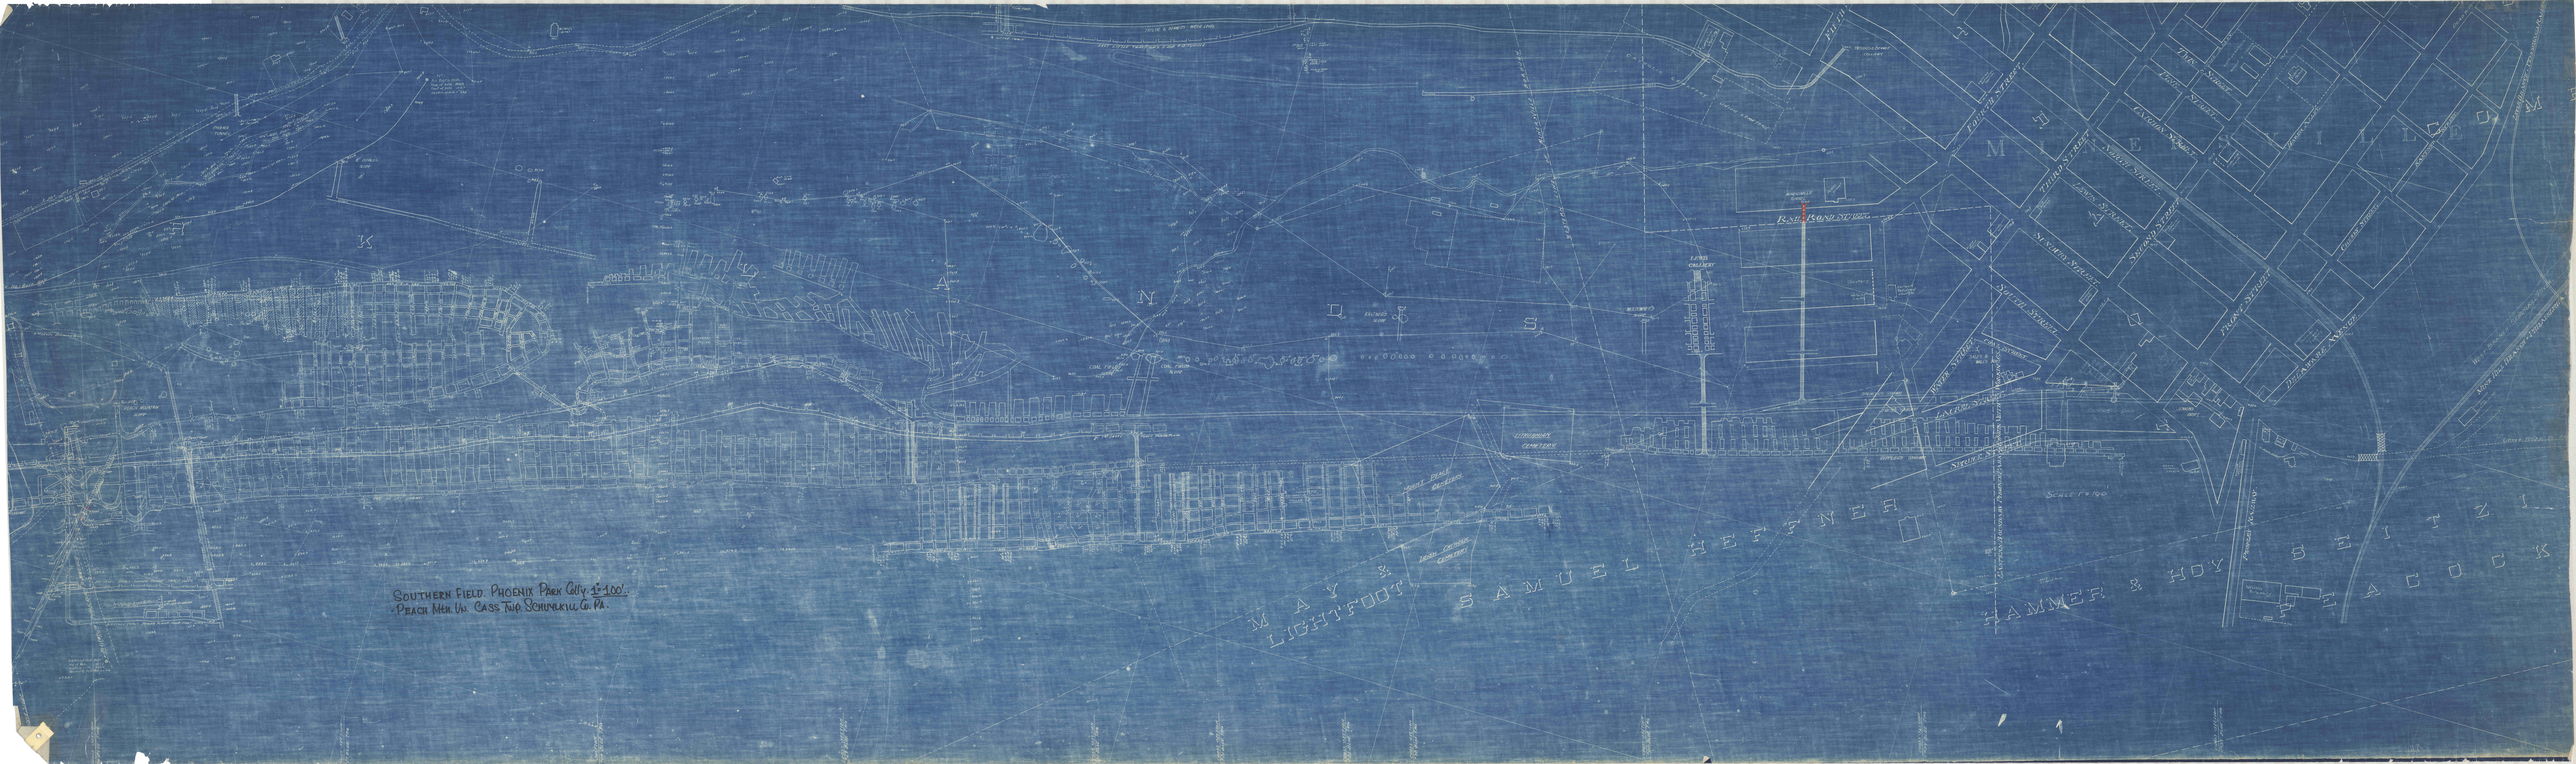

SOUTHERN FIELD. PHOENIX PARK CITY. 1"=100'.
PEACH MTN. VIL. CASS TWP. SCHUYLKILL CO. PA.