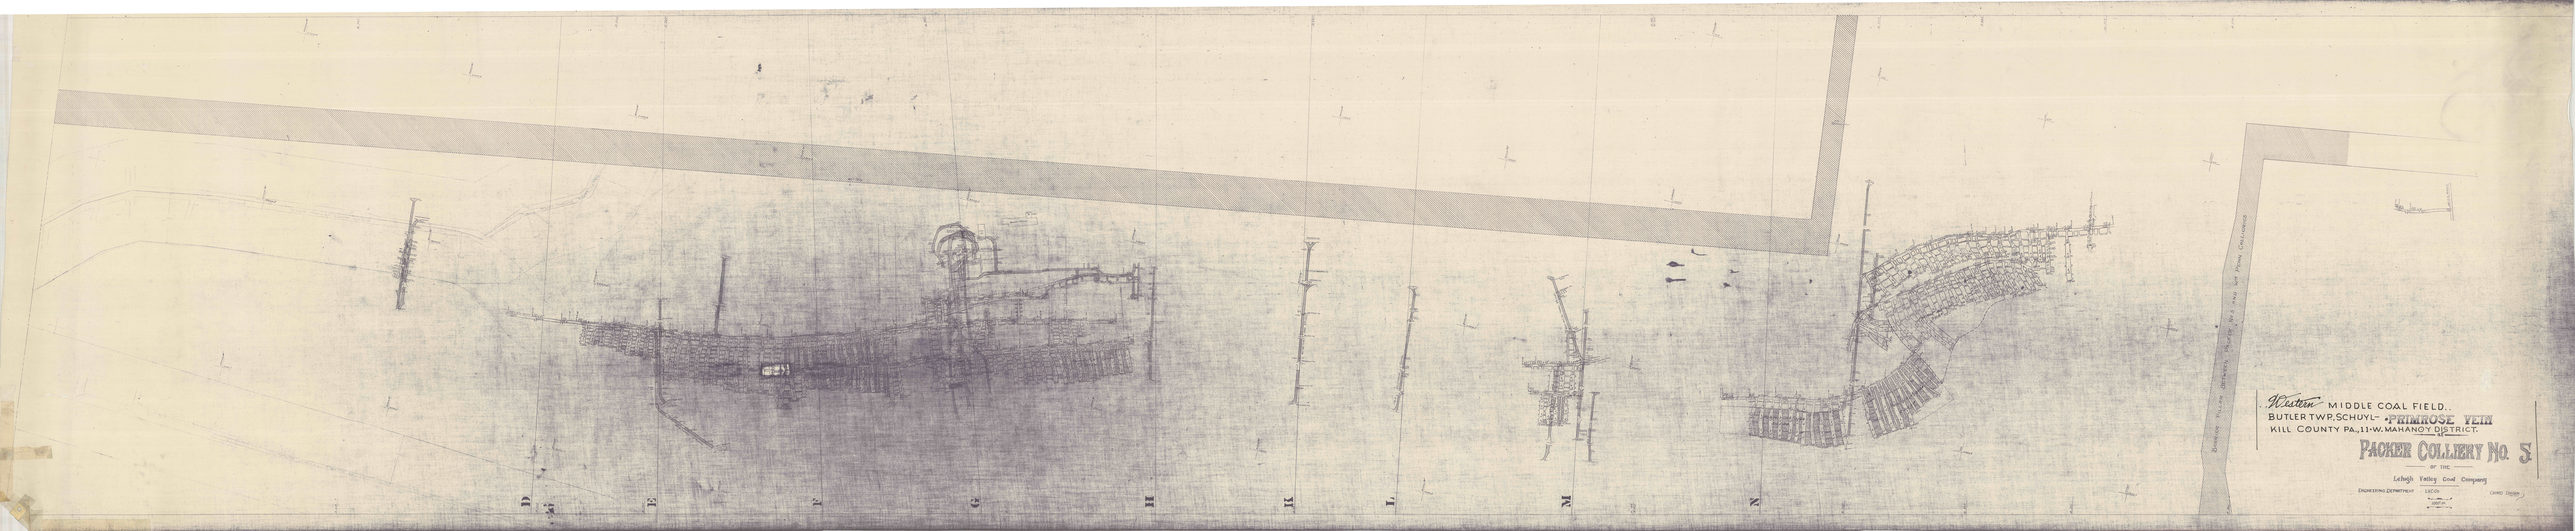

D
E
F
G
H
K
L
M
N
Western MIDDLE COAL FIELD.
BUTLER TWP, SCHUYL- PRIMROSE VEIN
KILL COUNTY PA., 11 W. MAHANOY DISTRICT.
PACKER COLLIERY No. 5
OF THE
Lehigh Valley Coal Company
ENGINEERING DEPARTMENT
LUCIN
CHIEF ENGINEER