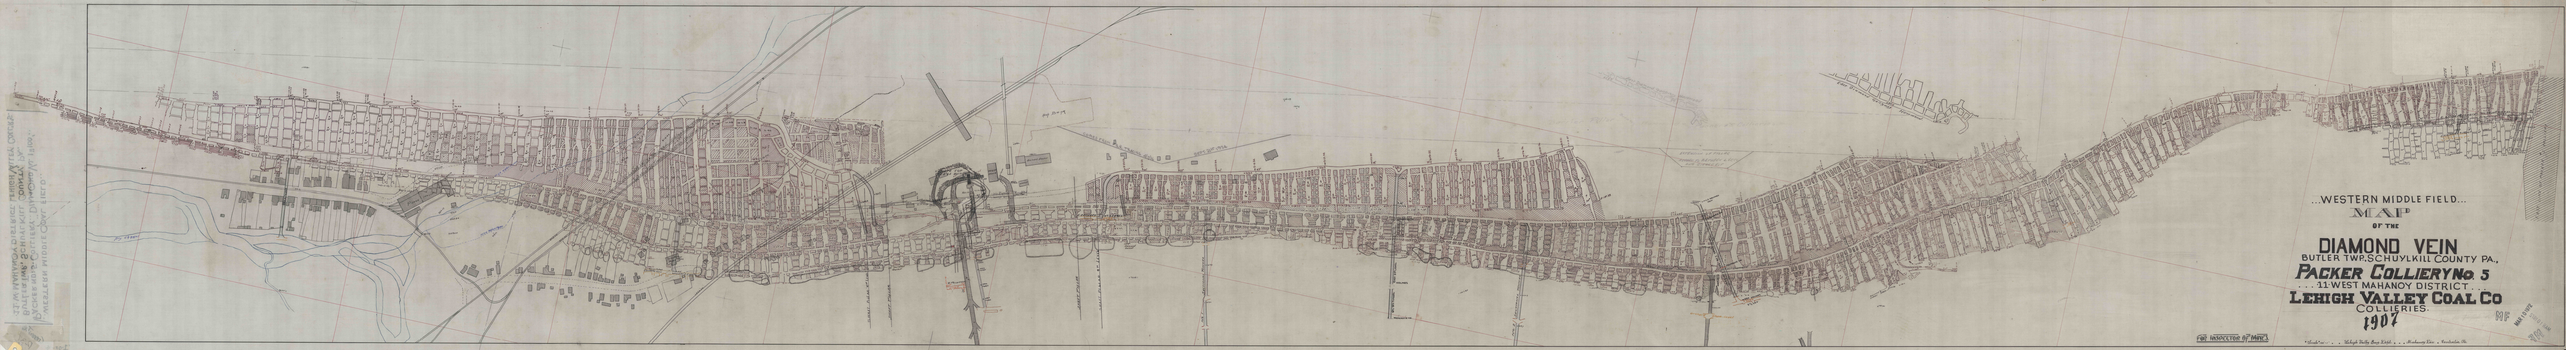
...WESTERN MIDDLE FIELD...
MAP
OF THE
DIAMOND VEIN
BUTLER TWP. SCHUYLKILL COUNTY PA.,
PACKER COLLIERY No 5
...11 WEST MAHANOY DISTRICT...
LEHIGH VALLEY COAL CO
COLLIERIES.
1907
FOR INSPECTION OF MINES

1 OF 4