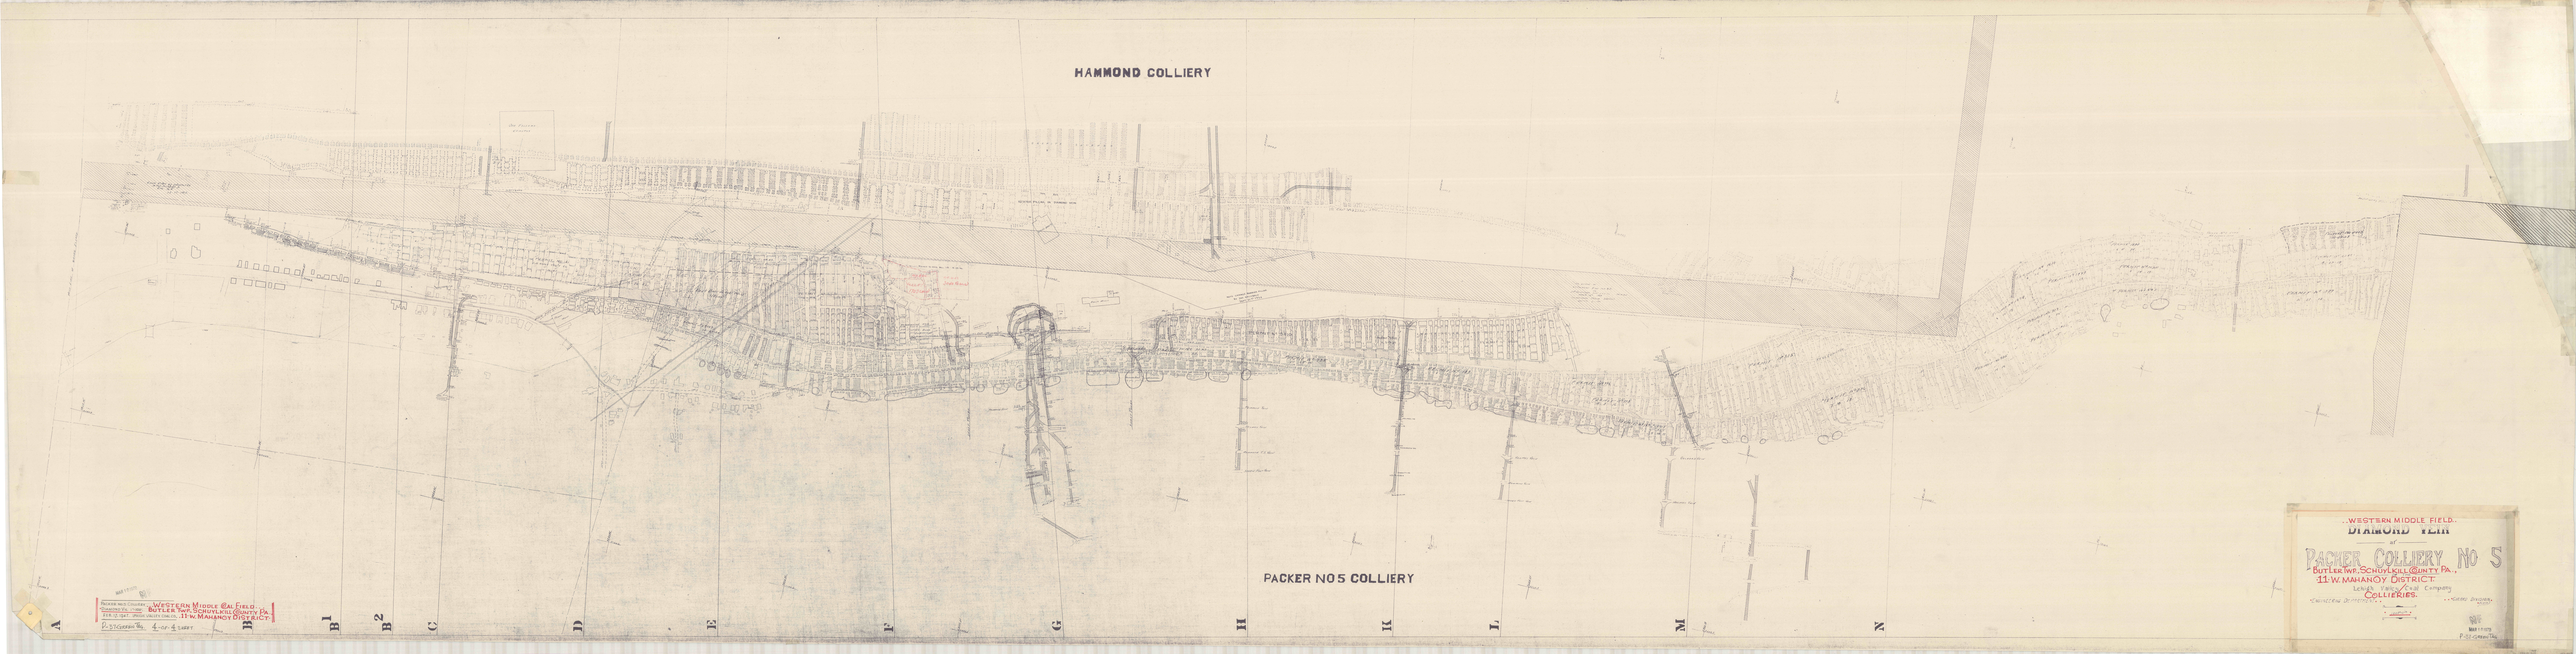

HAMMOND COLLIERY
PACKER NO 5 COLLIERY
A
B1
B2
C
D
E
F
G
H
K
L
M
N
WESTERN MIDDLE FIELD.
DIAMOND VEIN
of
PACKER COLLIERY NO 5
BUTLER TWP. SCHUYLKILL COUNTY PA.,
11 W. MAHANOY DISTRICT.
COLLIERIES.