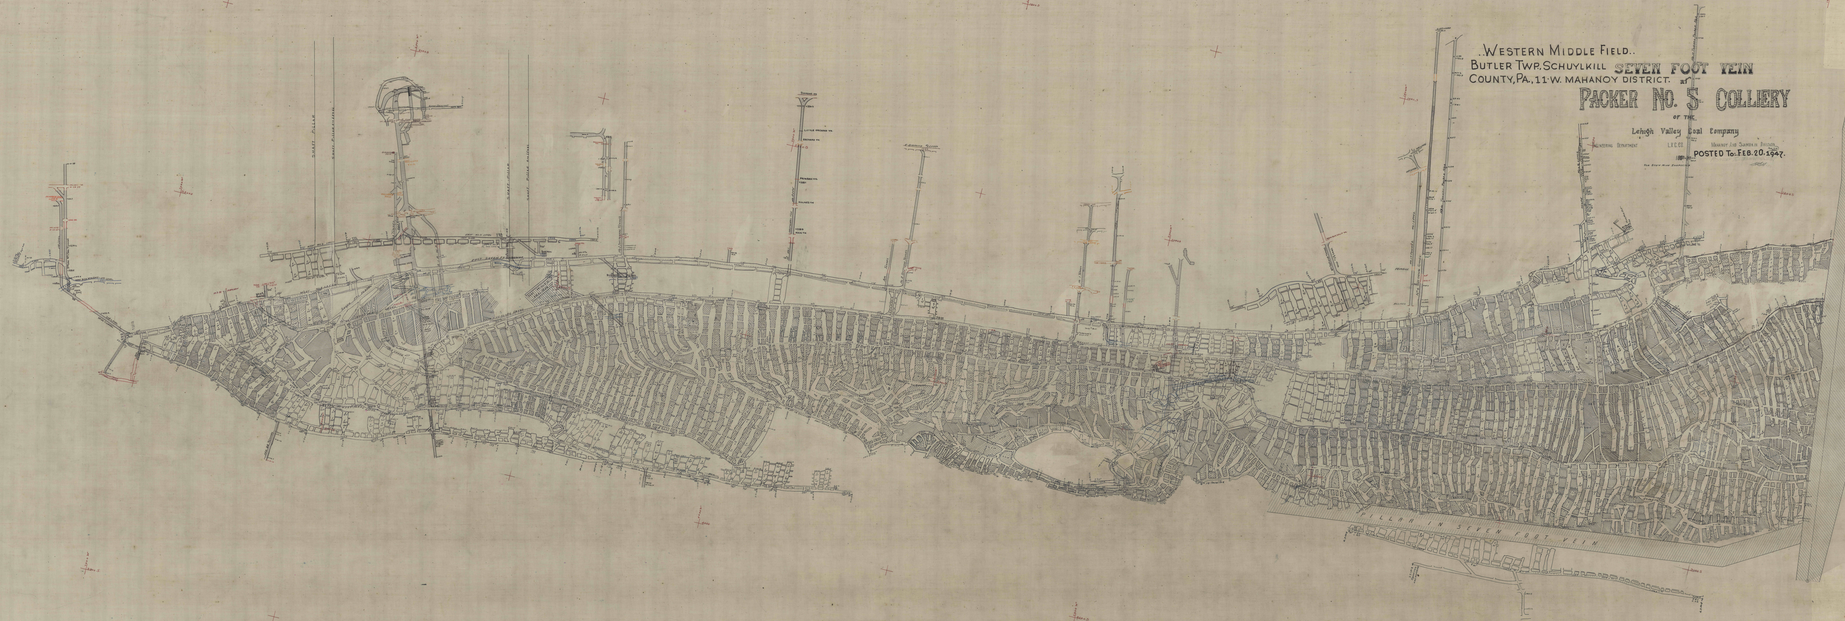

WESTERN MIDDLE FIELD.
BUTLER TWP. SCHUYLKILL COUNTY, PA., 11 W. MAHANOY DISTRICT.
SEVEN FOOT VEIN
PACKER NO. 5 COLLIERY
OF THE
Lehigh Valley Coal Company
POSTED TO FEB. 20, 1947.