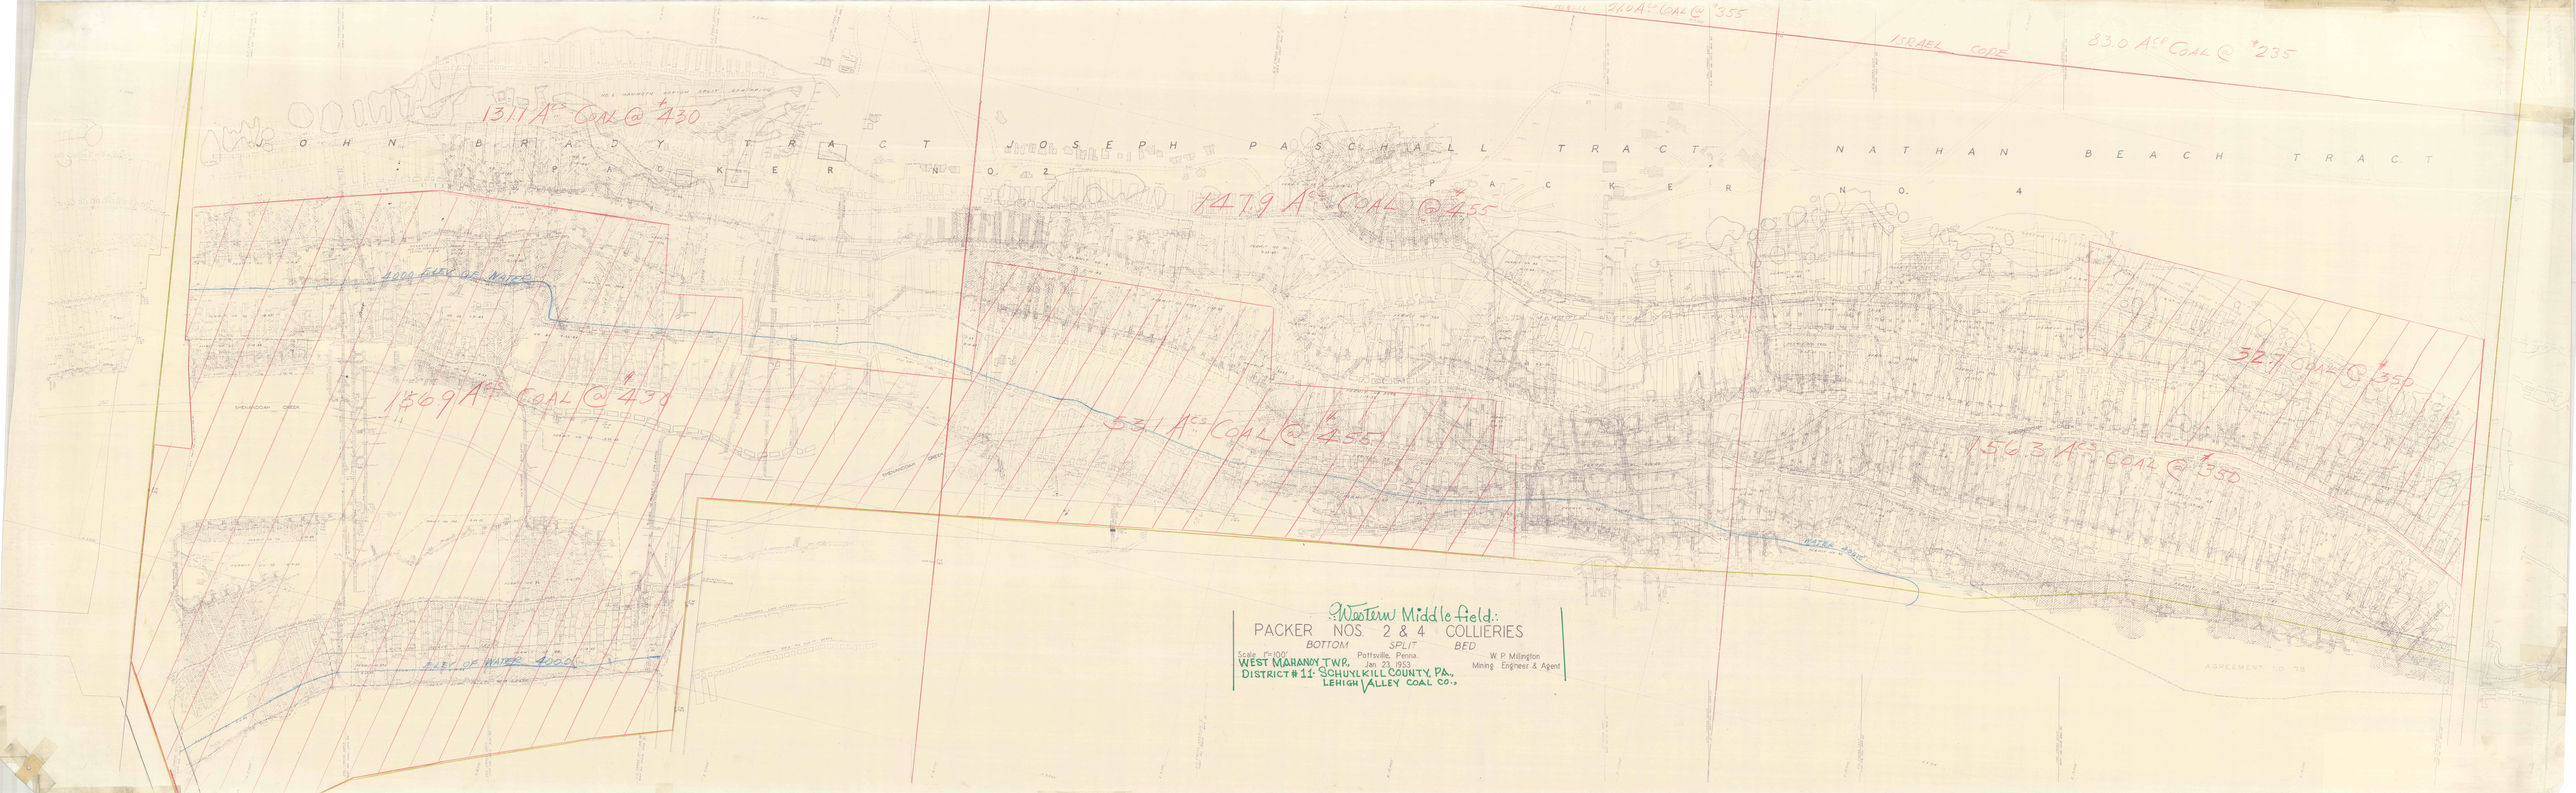
1311 Acs COAL @ 430
JOHN BRADY TRACT
PACKER NO. 2
1000 FEET OF WATER
1369 Acs COAL @ 438
1000 FEET OF WATER
JOSEPH PASCHALL TRACT
1479 Acs COAL @ 455
531 Acs COAL @ 455
ISRAEL CODE
430 Acs COAL @ 355
830 Acs COAL @ 235
NATHAN BEACH TRACT
PACKER NO. 4
327 COAL @ 350
1563 Acs COAL @ 350
WATER LEVEL
AGREEMENT NO. 38
Western Middle field.
PACKER NOS. 2 & 4 COLLIERIES
BOTTOM SPLIT BED
Scale 1"=100' Pottsville, Penna. W. P. Millington
Jan. 29, 1953 Mining Engineer & Agent
WEST MAHANOY TWP, SCHUYLKILL COUNTY, PA.
DISTRICT #11 LEHIGH VALLEY COAL CO.