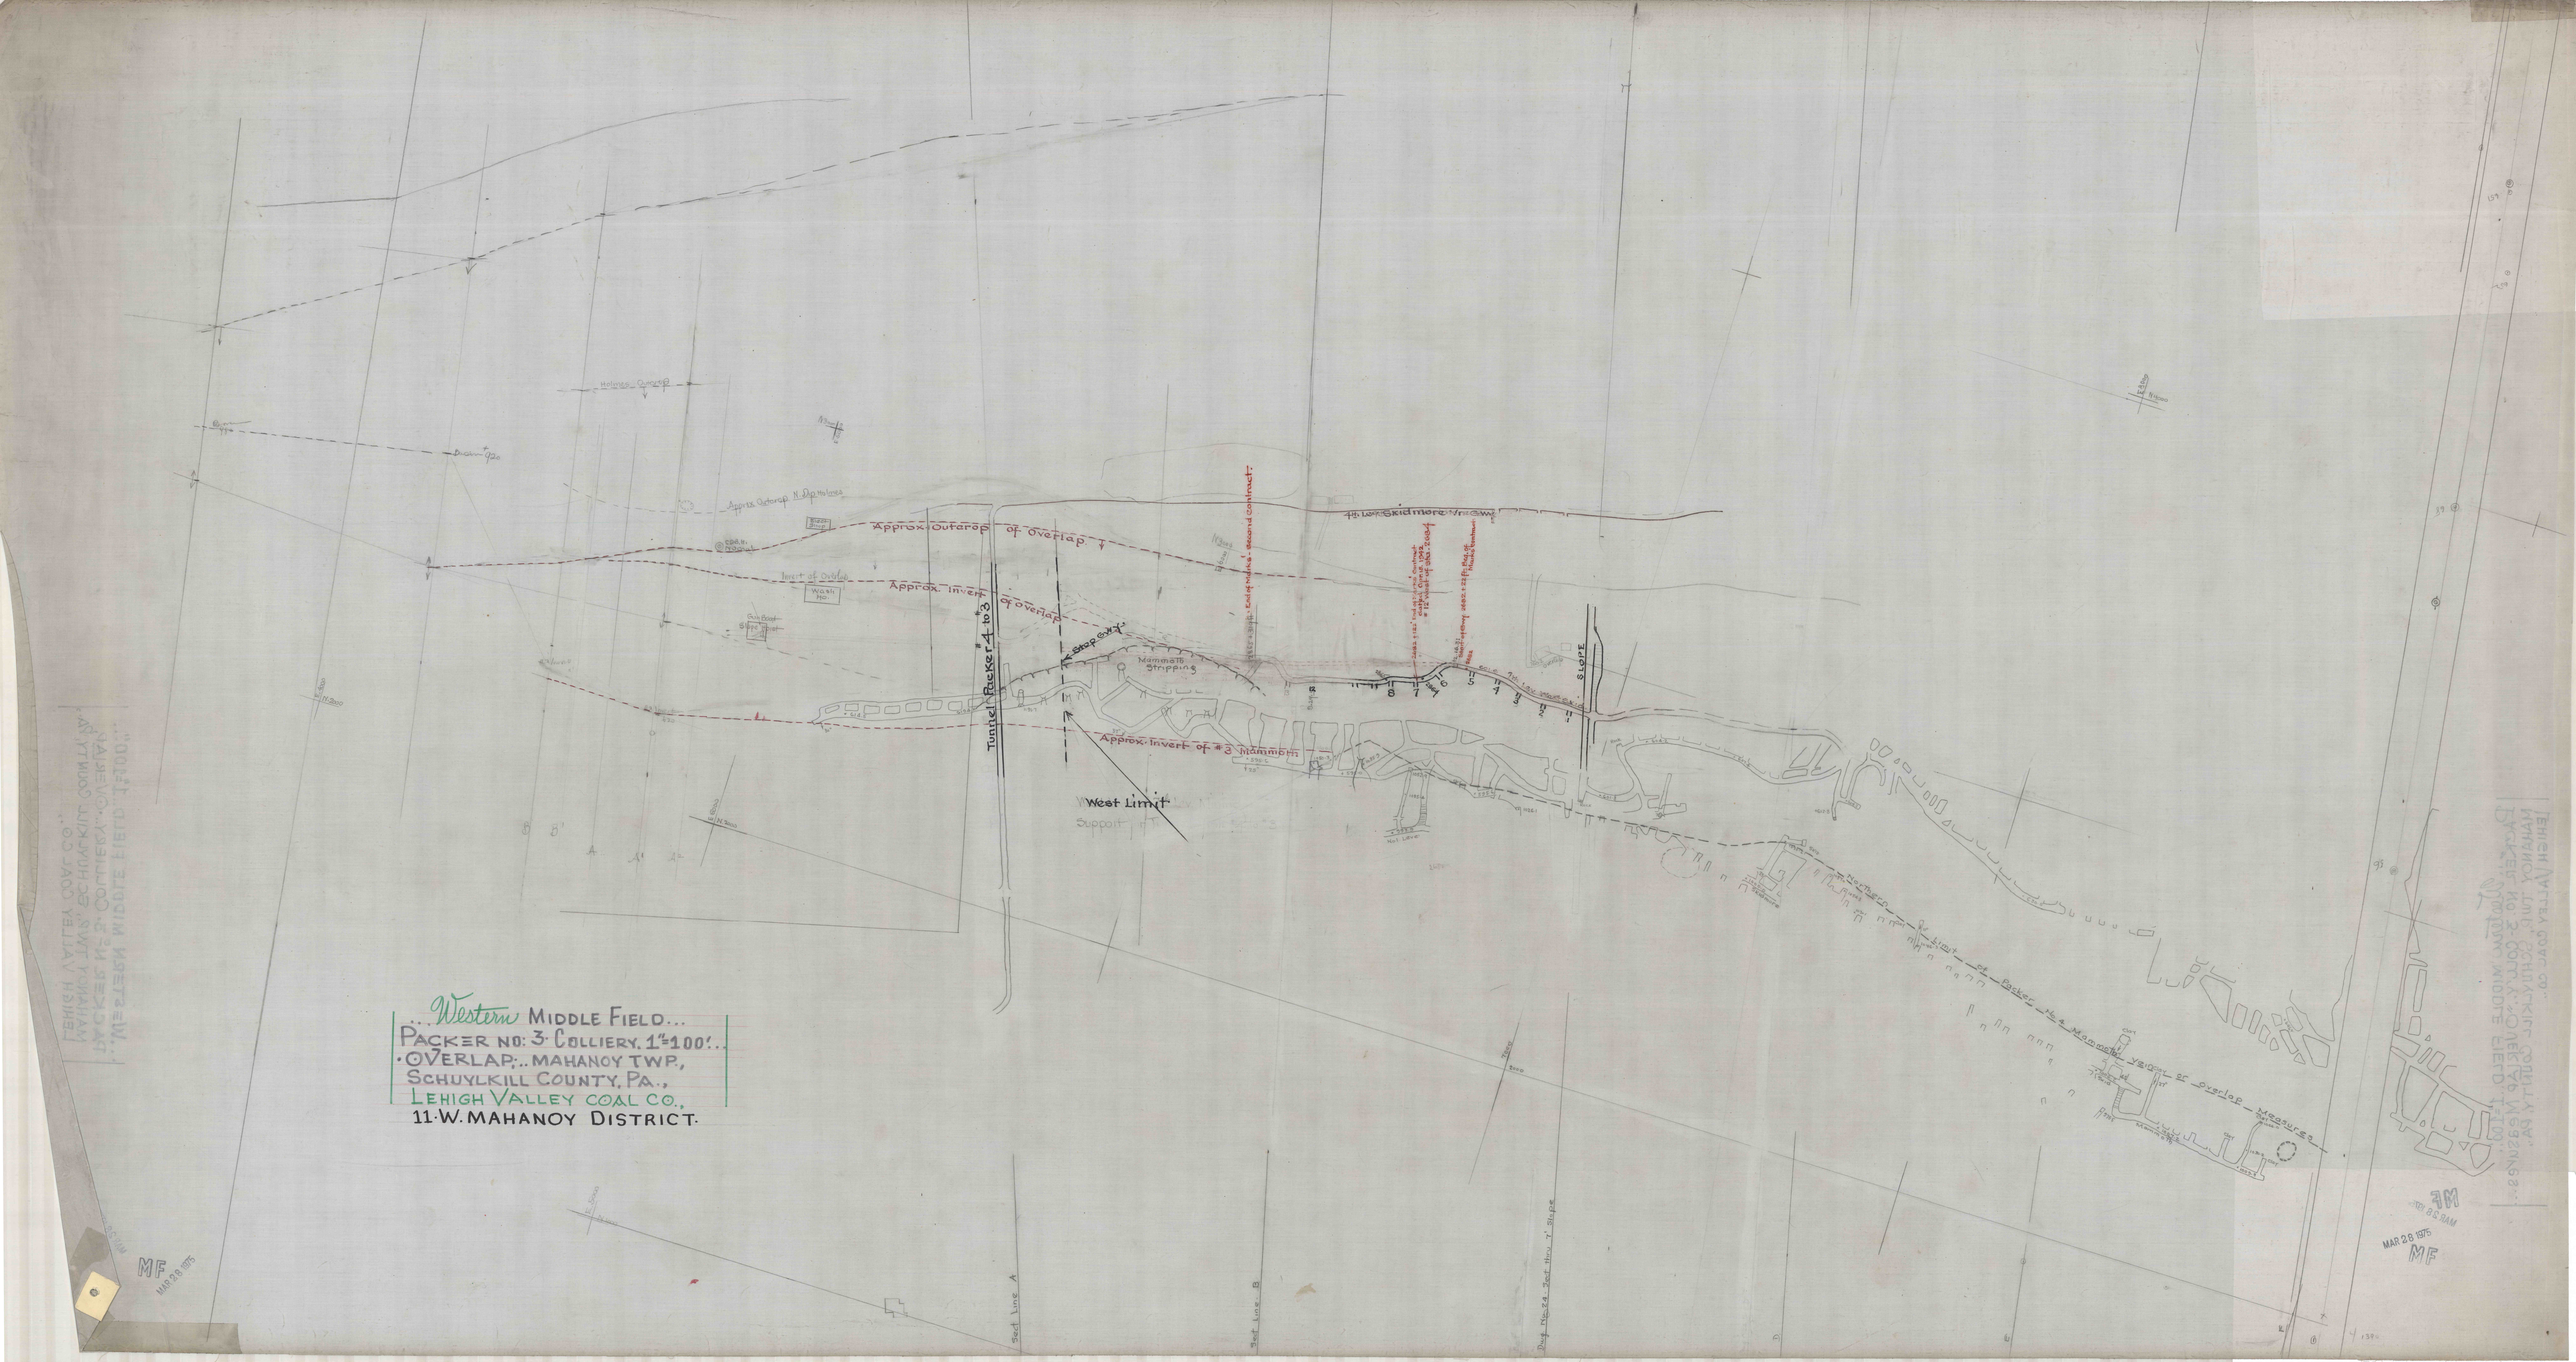
Approx. Outcrop of Overlap
Approx. Invert of Overlap
Approx. Invert of #3 Mammoth
Tunnel Packer #4 to #3
Mammoth Strippings
West Limit
Slope
Approx. Outcrop N. Dip Holmes
Holmes Outcrop
Dip No. 24
Sect Line A
Sect Line B
Western MIDDLE FIELD...
PACKER NO: 3 COLLIERY. 1"=100'..
OVERLAP;.. MAHANOY TWP.,
SCHUYLKILL COUNTY, PA.,
LEHIGH VALLEY COAL CO.,
11 W. MAHANOY DISTRICT.
MAR 28 1975
MF