


Packer 4 BANK FIRE

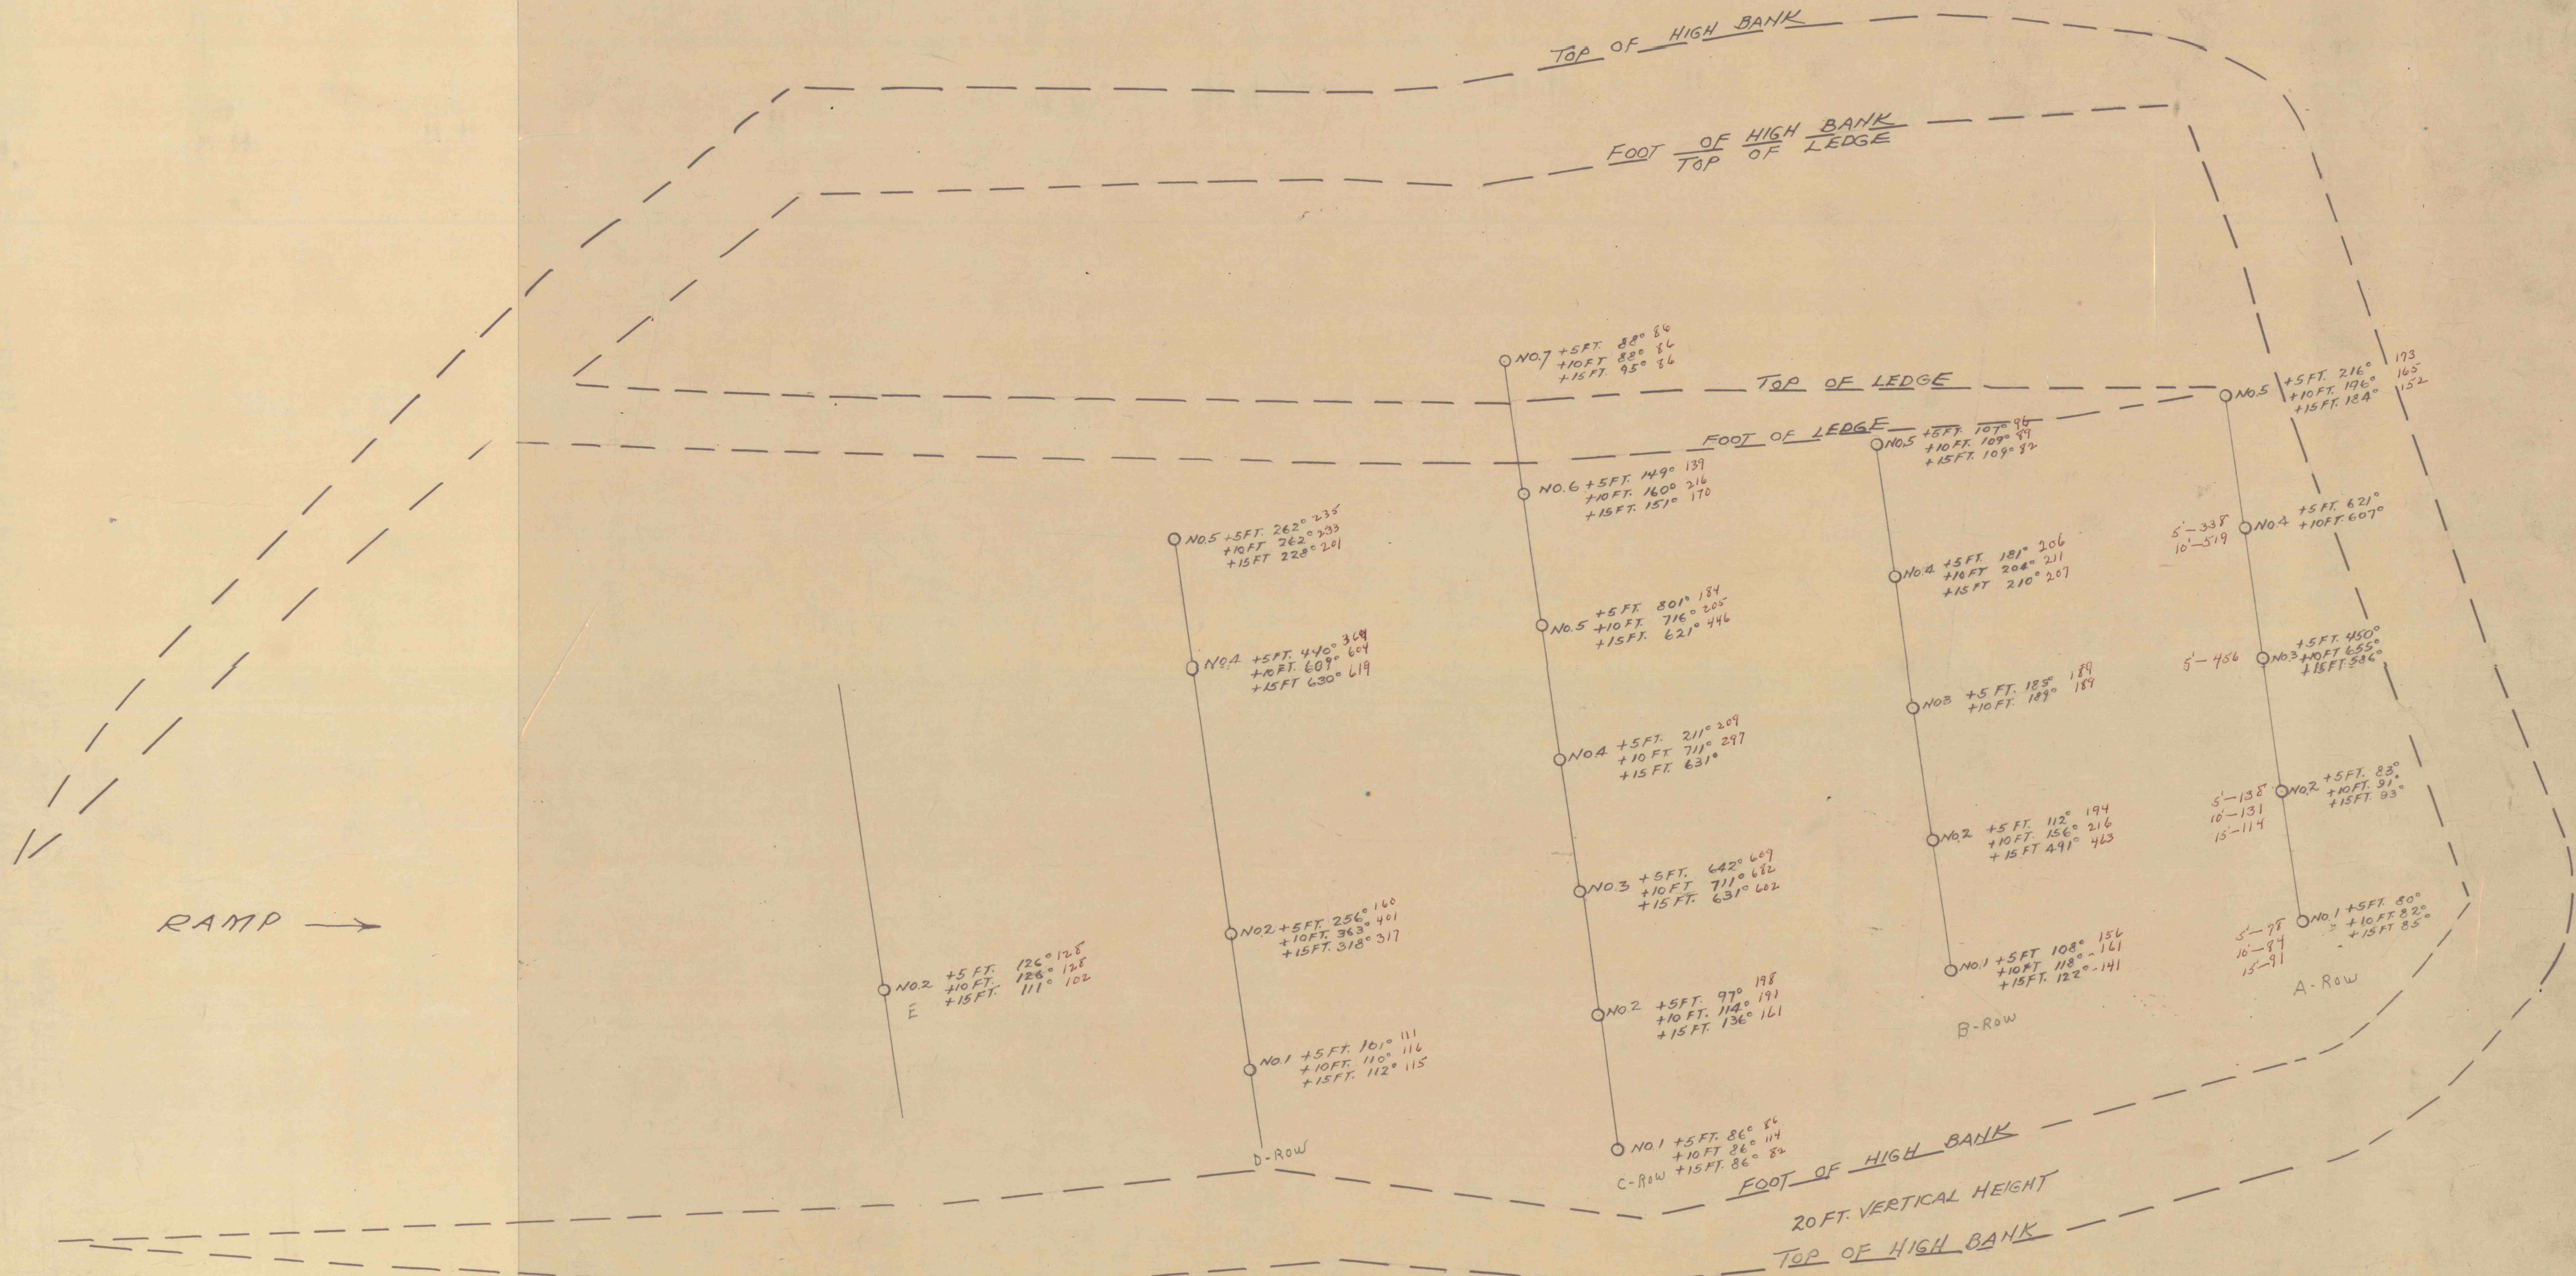

APR 9 1975

MF

WESTERN MIDDLE FIELD.. 1"=10'.

PACKER NO 4. COLLIERY. = BANK FIRE.

MAHANAY TWP. W. MAH. DISTRICT. SCHUYLKILL COUNTY, PA. LEHIGH VALLEY COAL CO.

BLACK TEMPERATURES: MAY 11, 1970.

RED " " : MAY 18, 1970.

MF

APR 9 1975