


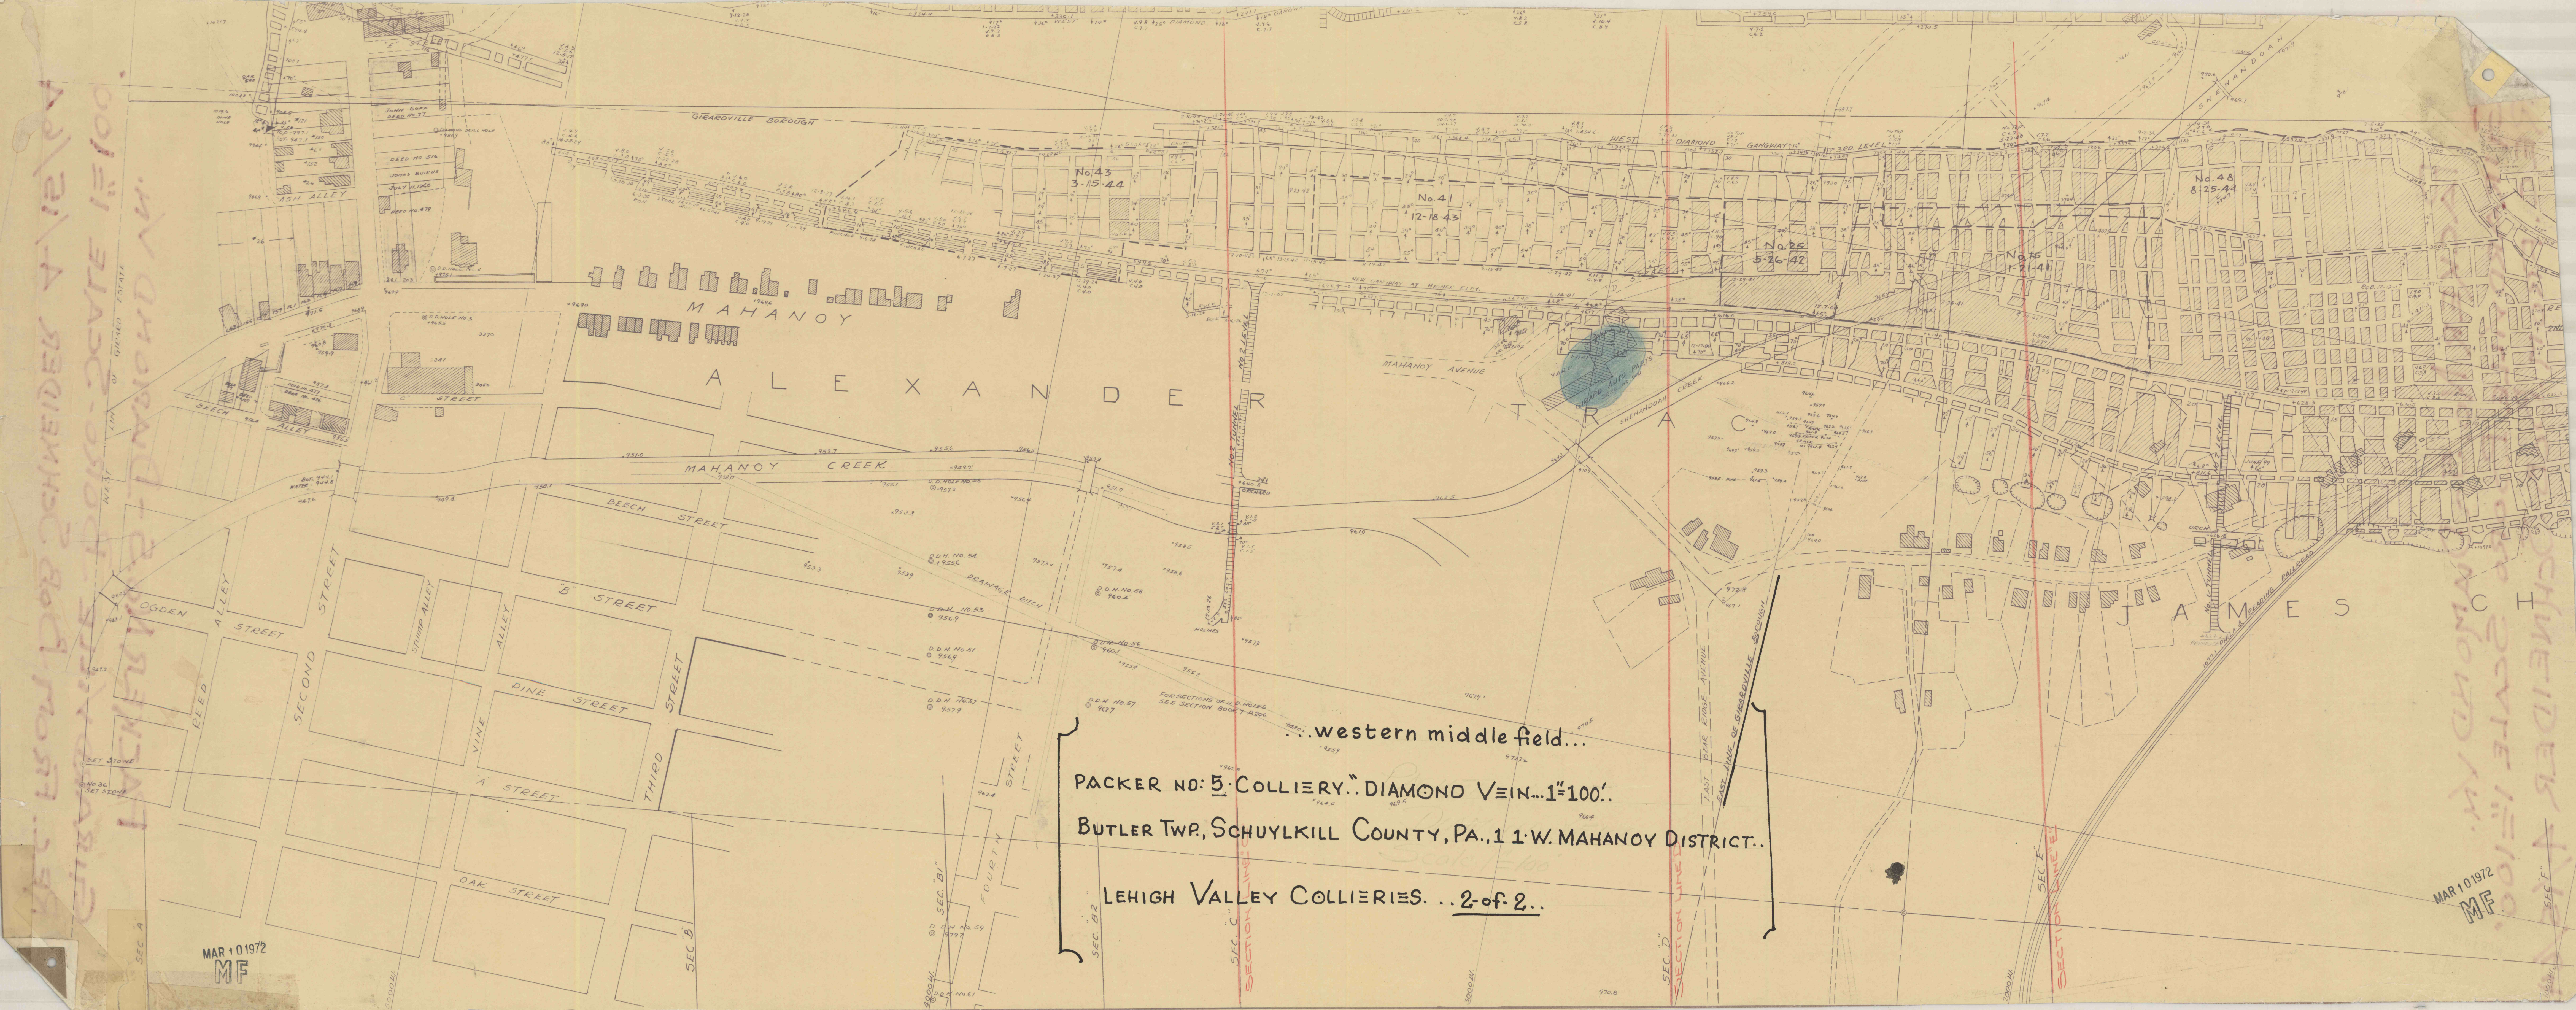

western middle field...

PACKER NO: 5. COLLIERIES. DIAMOND VEIN... 1"=100'.

BUTLER TWP, SCHUYLKILL COUNTY, PA., 1 1' W. MAHANOY DISTRICT..

LEHIGH VALLEY COLLIERIES. ..2 of 2..

MAR 10 1972
MF

MAR 10 1972
MF