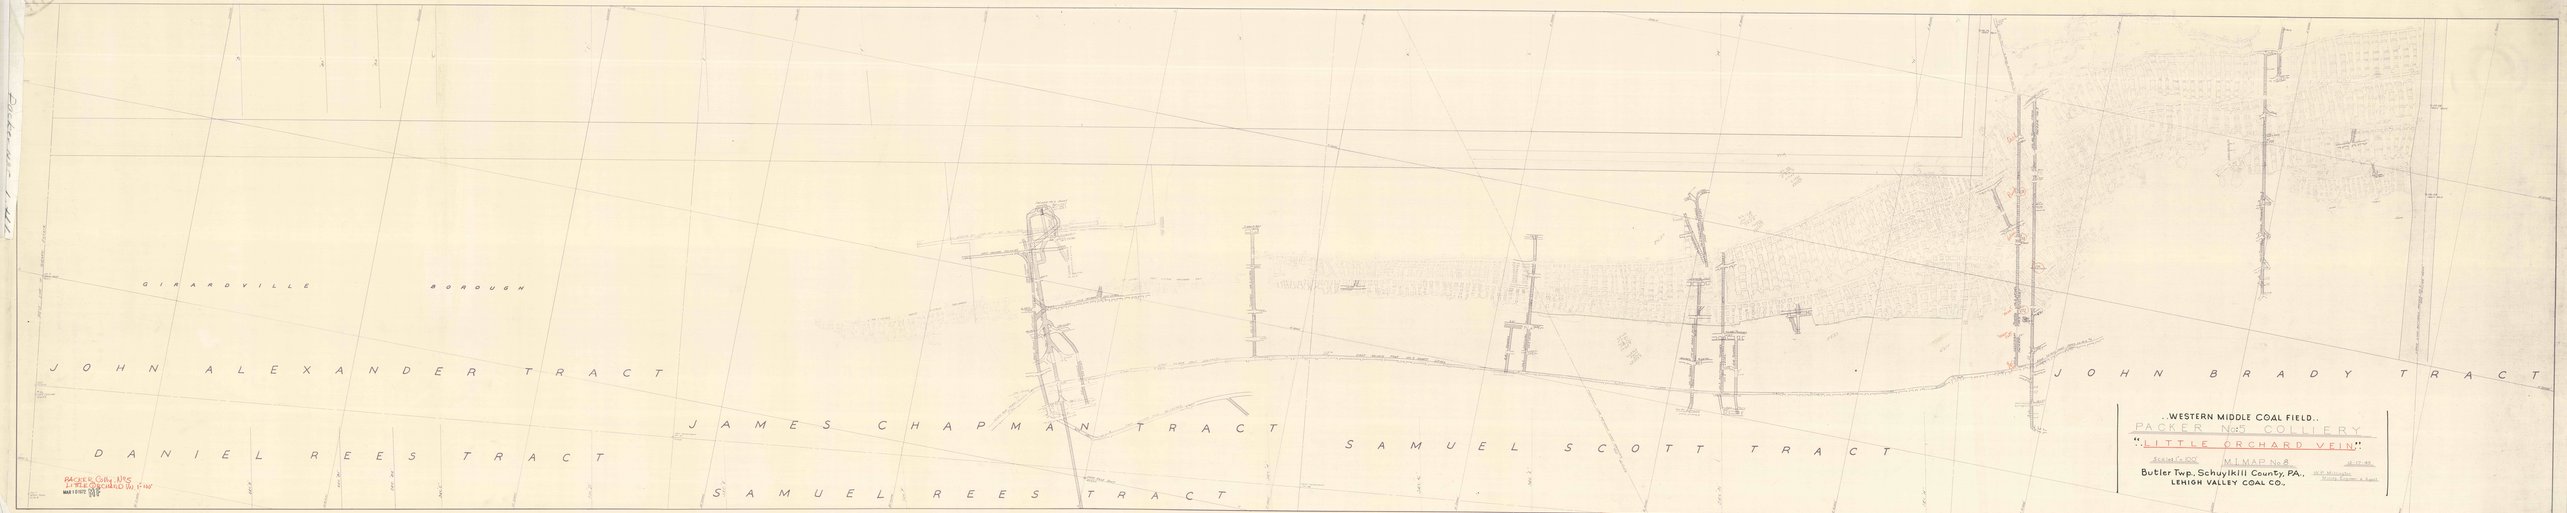
GIRARDVILLE BOROUGH
JOHN ALEXANDER TRACT
DANIEL REES TRACT
JAMES CHAPMAN TRACT
SAMUEL REES TRACT
SAMUEL SCOTT TRACT
JOHN BRADY TRACT
PACKER GRAV. LINE
LITTLE ORCHARD IN 1'=40'
MAR 1 1909
..WESTERN MIDDLE COAL FIELD..
PACKER No.5 COLLIERY
"LITTLE ORCHARD VEIN"
Scale 1" = 200'
M.I. MAP No. 8
Butler Twp. Schuylkill County, PA.
LEHIGH VALLEY COAL CO.