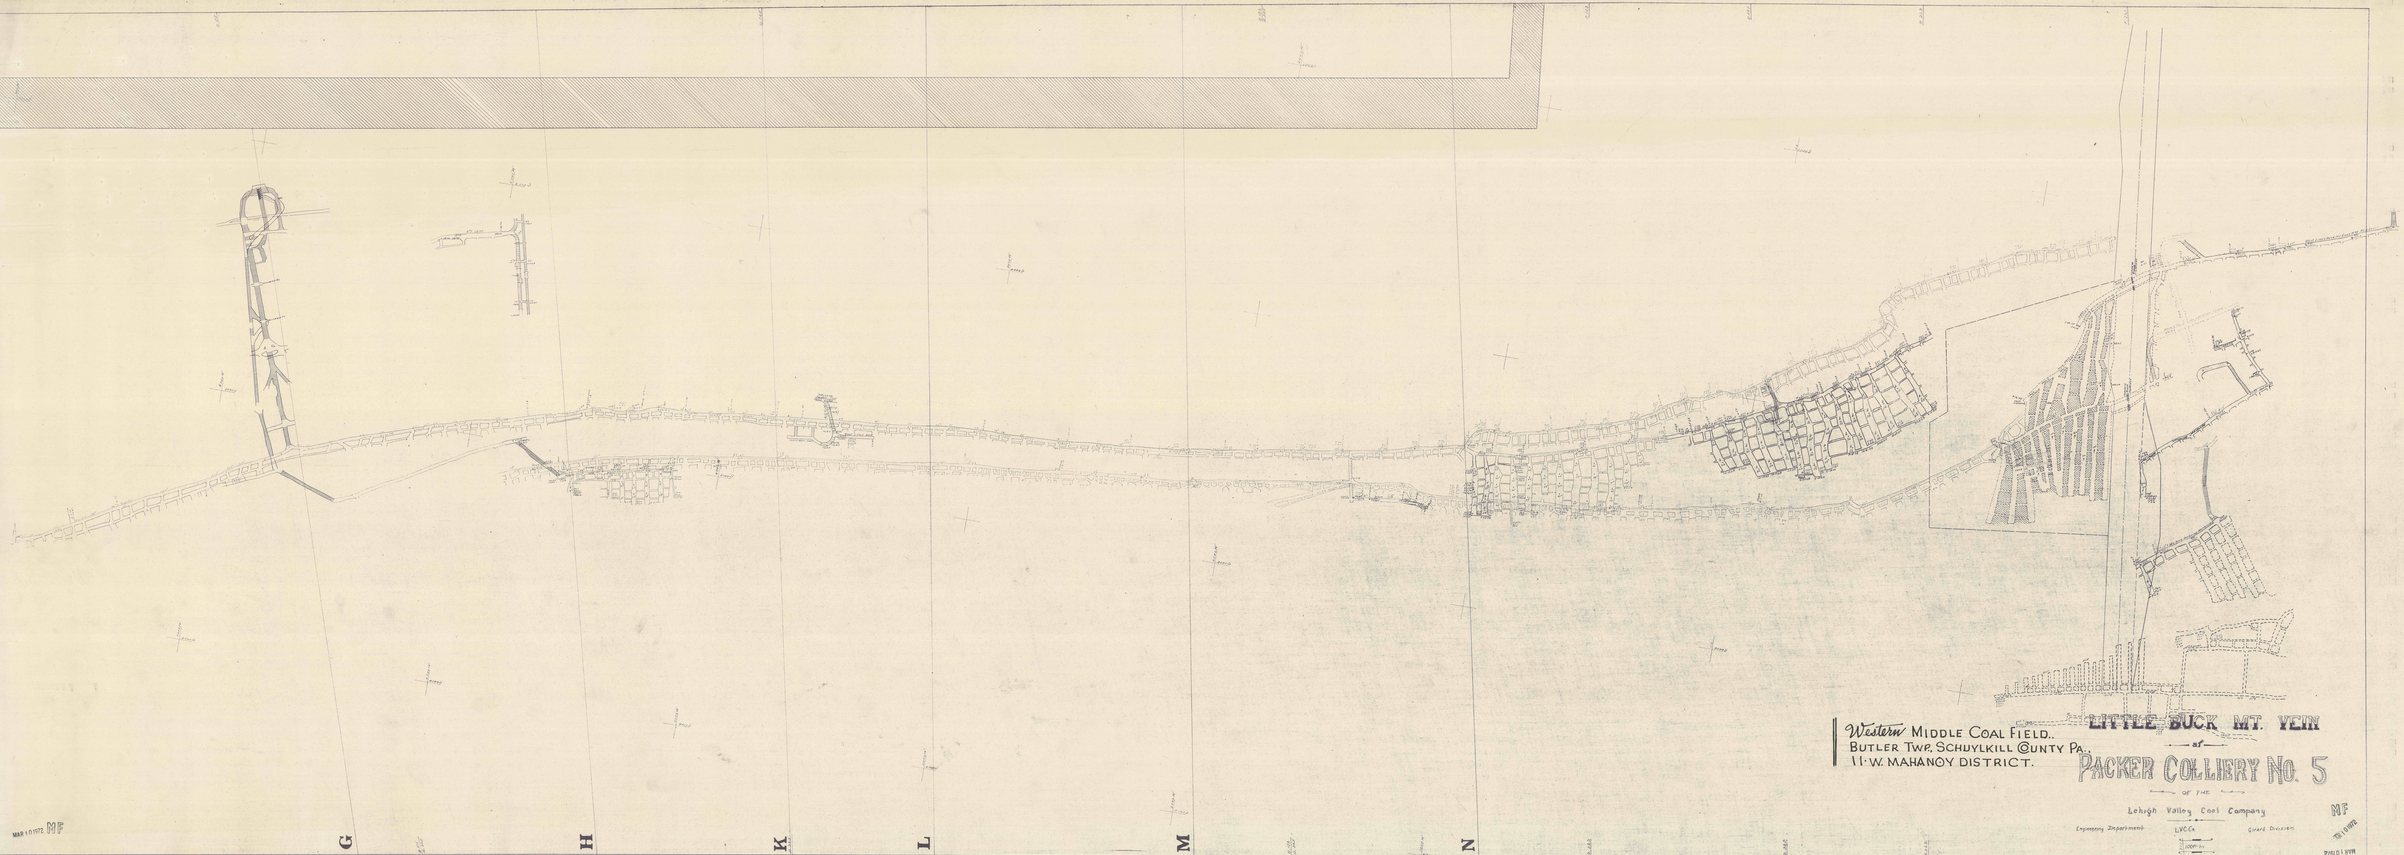
G
H
K
L
M
N
Western Middle Coal Field.
Butler Twp, Schuylkill County Pa.,
11 W. Mahanoy District.
LITTLE BUCK MT. VEIN
of
PACKER COLLIERY No. 5
of the
Lehigh Valley Coal Company
Engineering Department
LVC Co
Grant Division
MAR 1 0 1972 MF