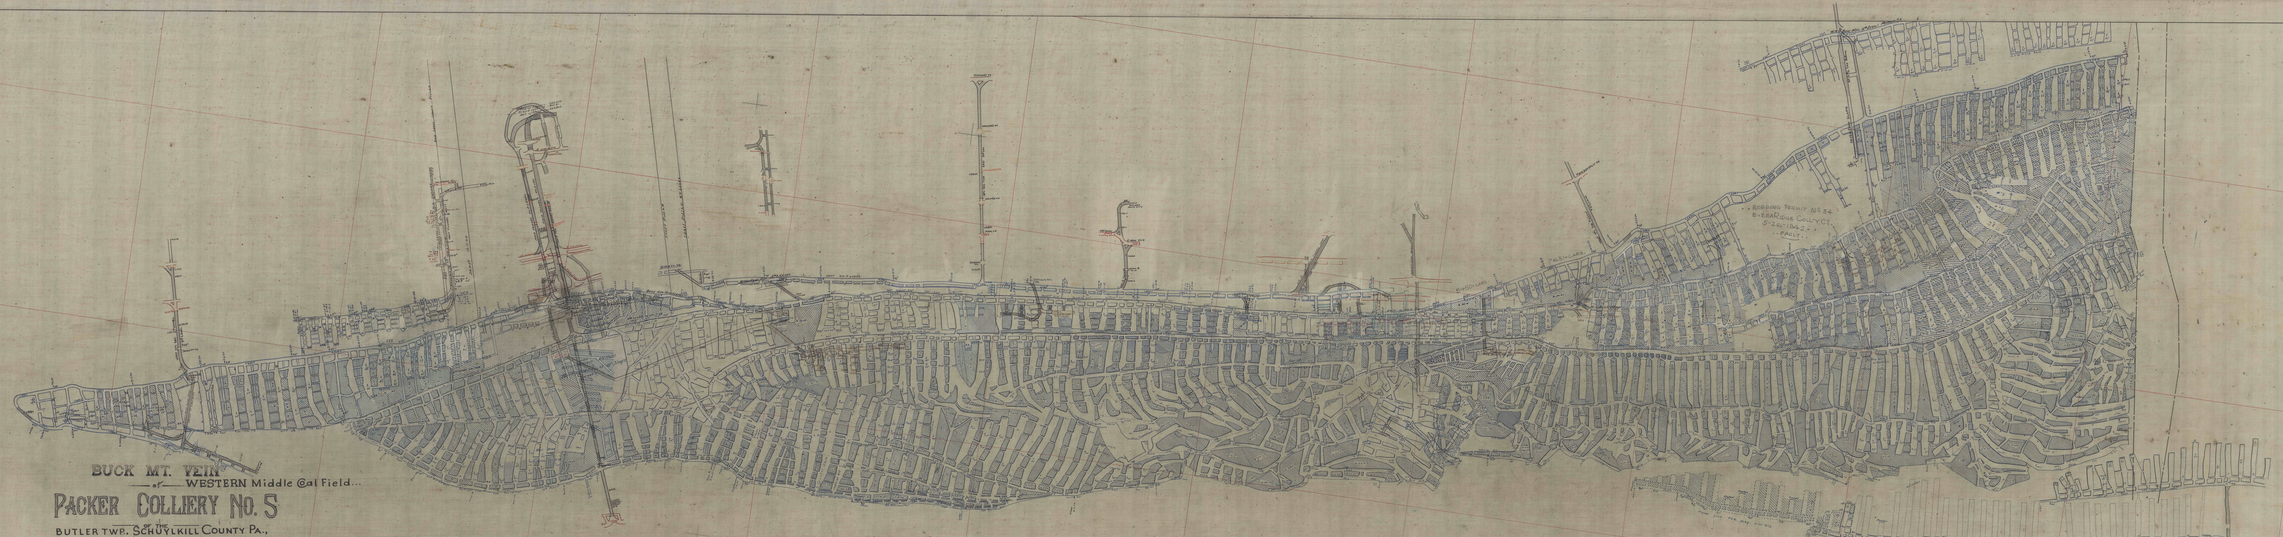
BUCK MT. VEIN
of WESTERN Middle Coal Field...
PACKER COLLIERY NO. 5
BUTLER TWP. SCHUYLKILL COUNTY PA.,
SCHUYLKILL
FAULT
