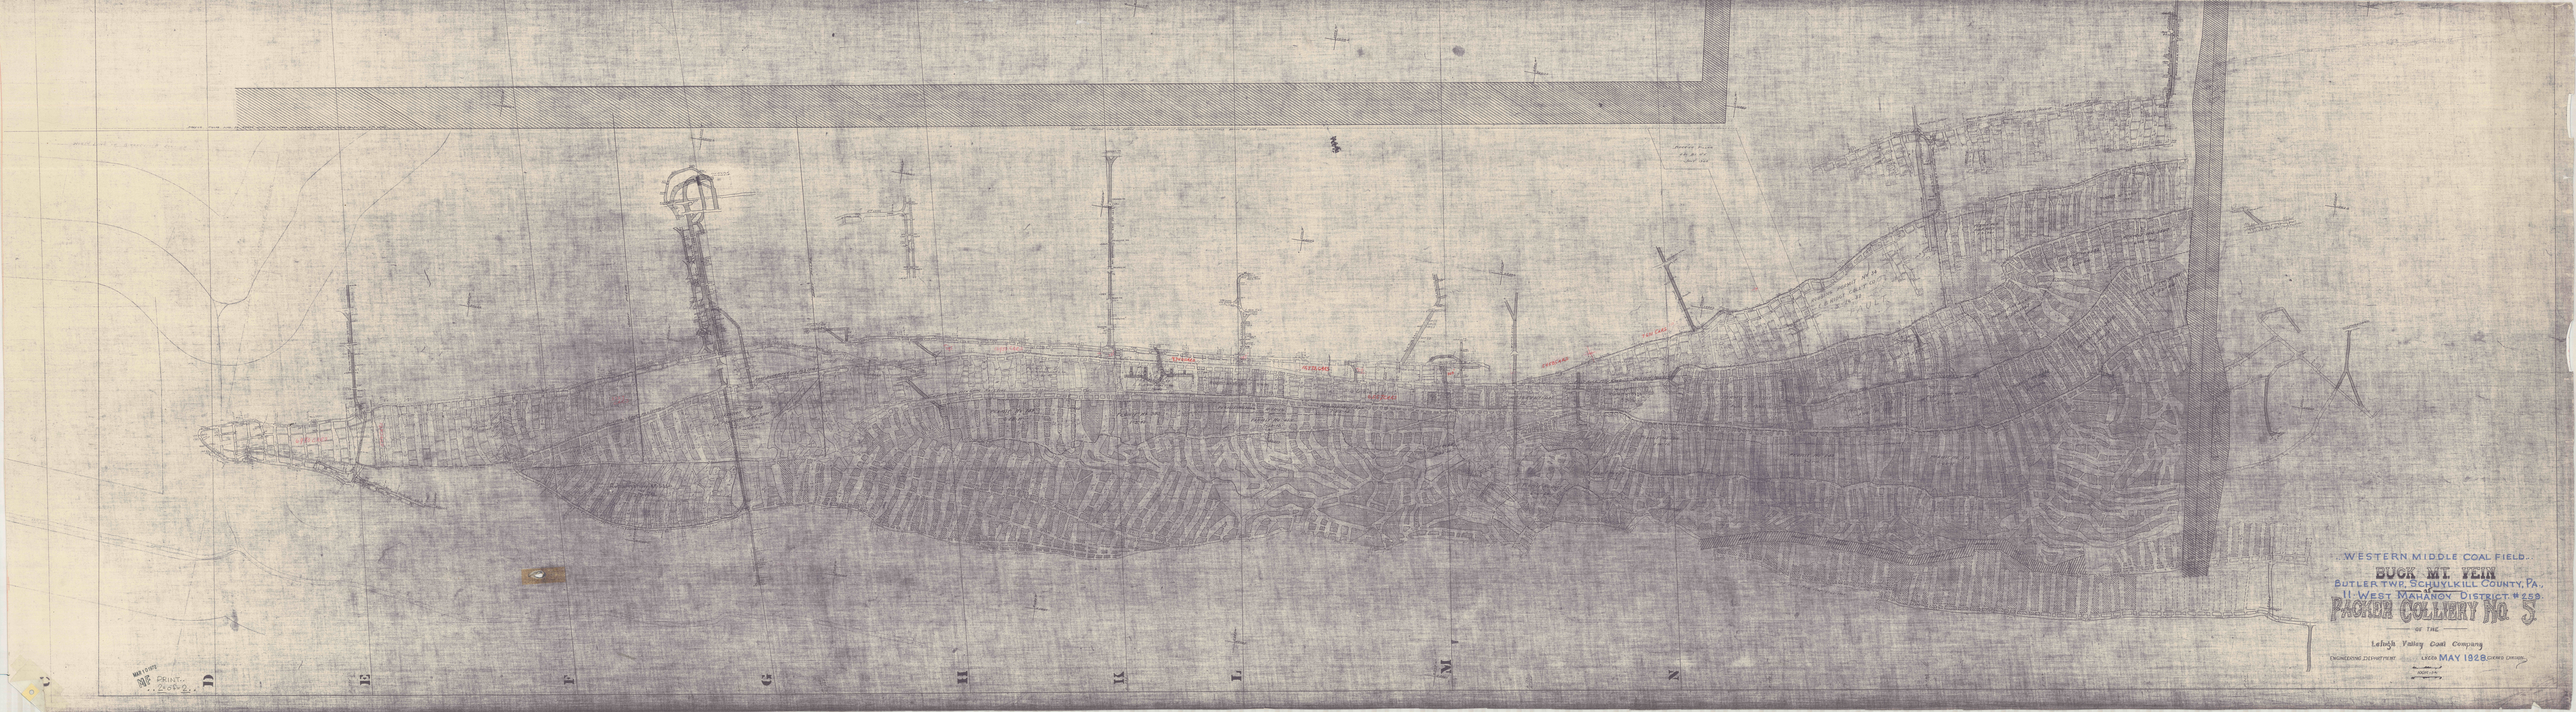

WESTERN MIDDLE COAL FIELD.
BUCK MT. VEIN
BUTLER TWP. SCHUYLKILL COUNTY, PA.
11 WEST MAHANOY DISTRICT #259.
PACKER COLLIERY No. 5
OF THE
Lehigh Valley Coal Company
ENGINEERING DEPARTMENT
SCALE MAY 1928 DRAWN
CHECKED
TRACED
COMPARED
MAY 1928
BLUE PRINT
SEP 26 1928
C
D
E
F
G
H
K
L
M
N