


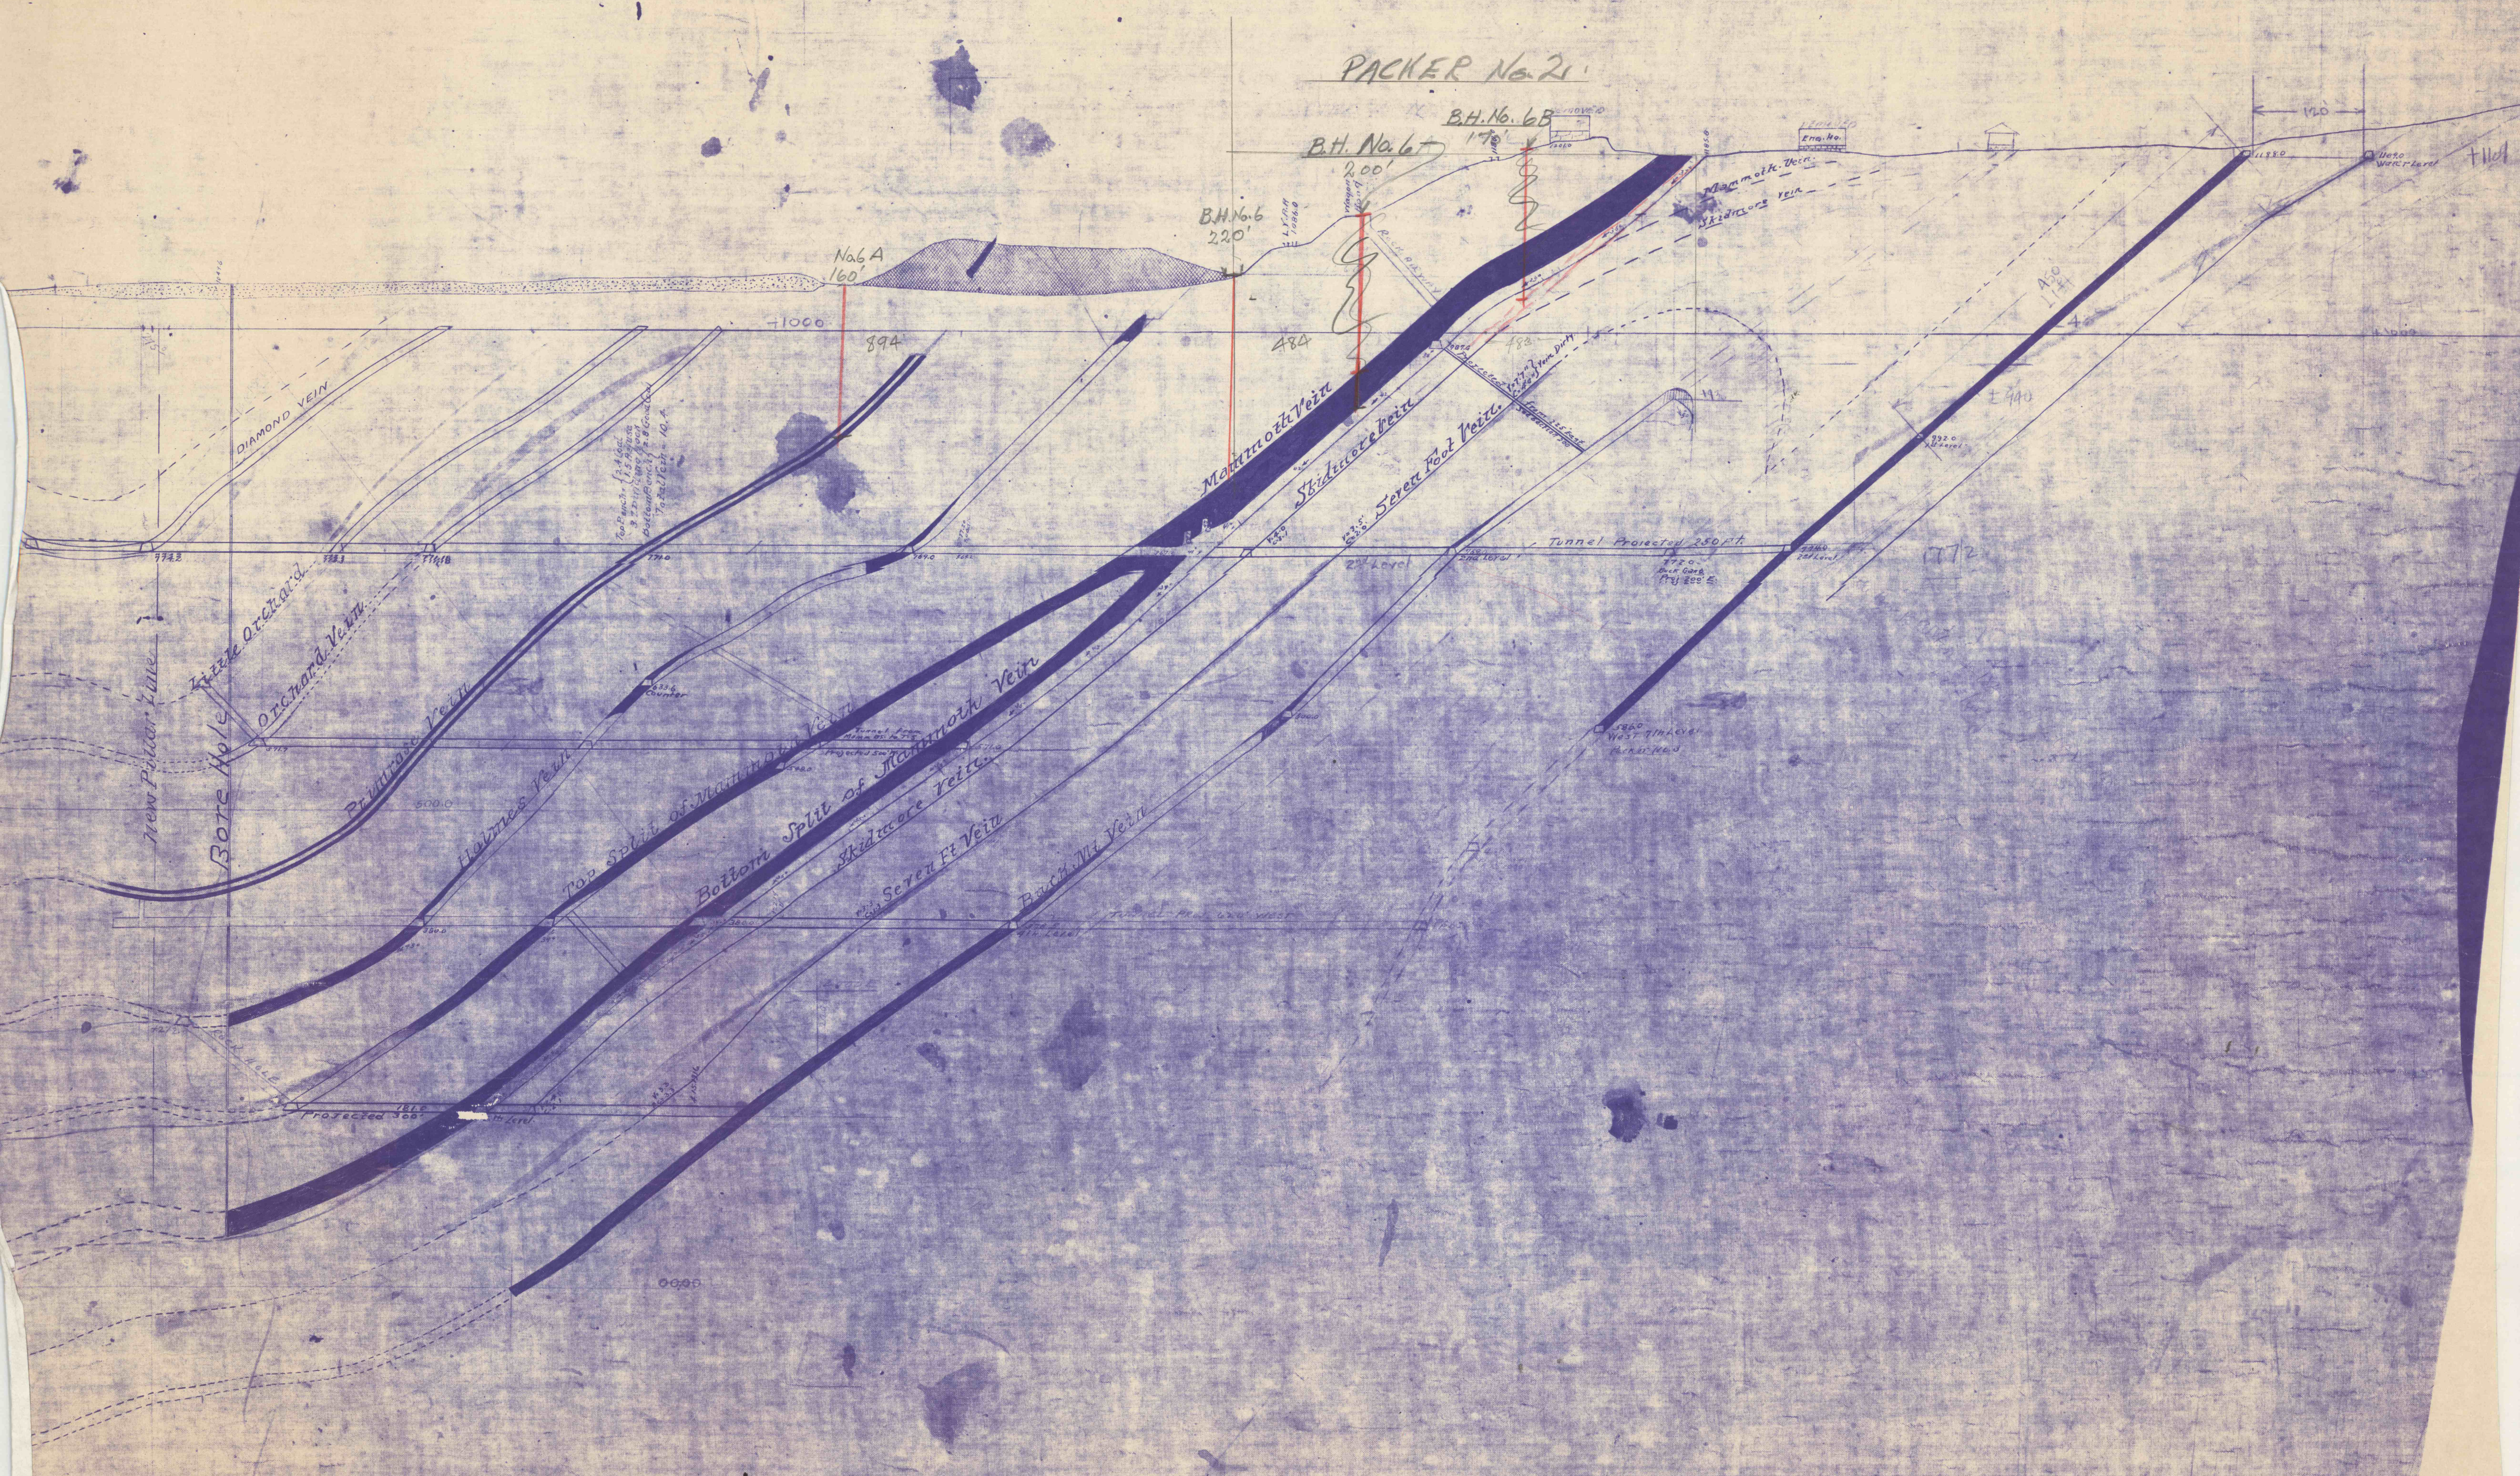

WESTERN MIDDLE COAL FIELD. MAHANOEY TWP, SCHUYLKILL COUNTY, PA.,
 11 W. MAHANOEY DISTRICT.
 Lehigh Valley Collieries.

"SECTION-THROUGH-MAIN-SLOPE."
 AT
 PACKER NO. 2 COLLIERY

SCALE 1"=100'
 Revised: Oct. 1910. CENTRALIA PA

TAG: P-1 ... 3 of 6..

C