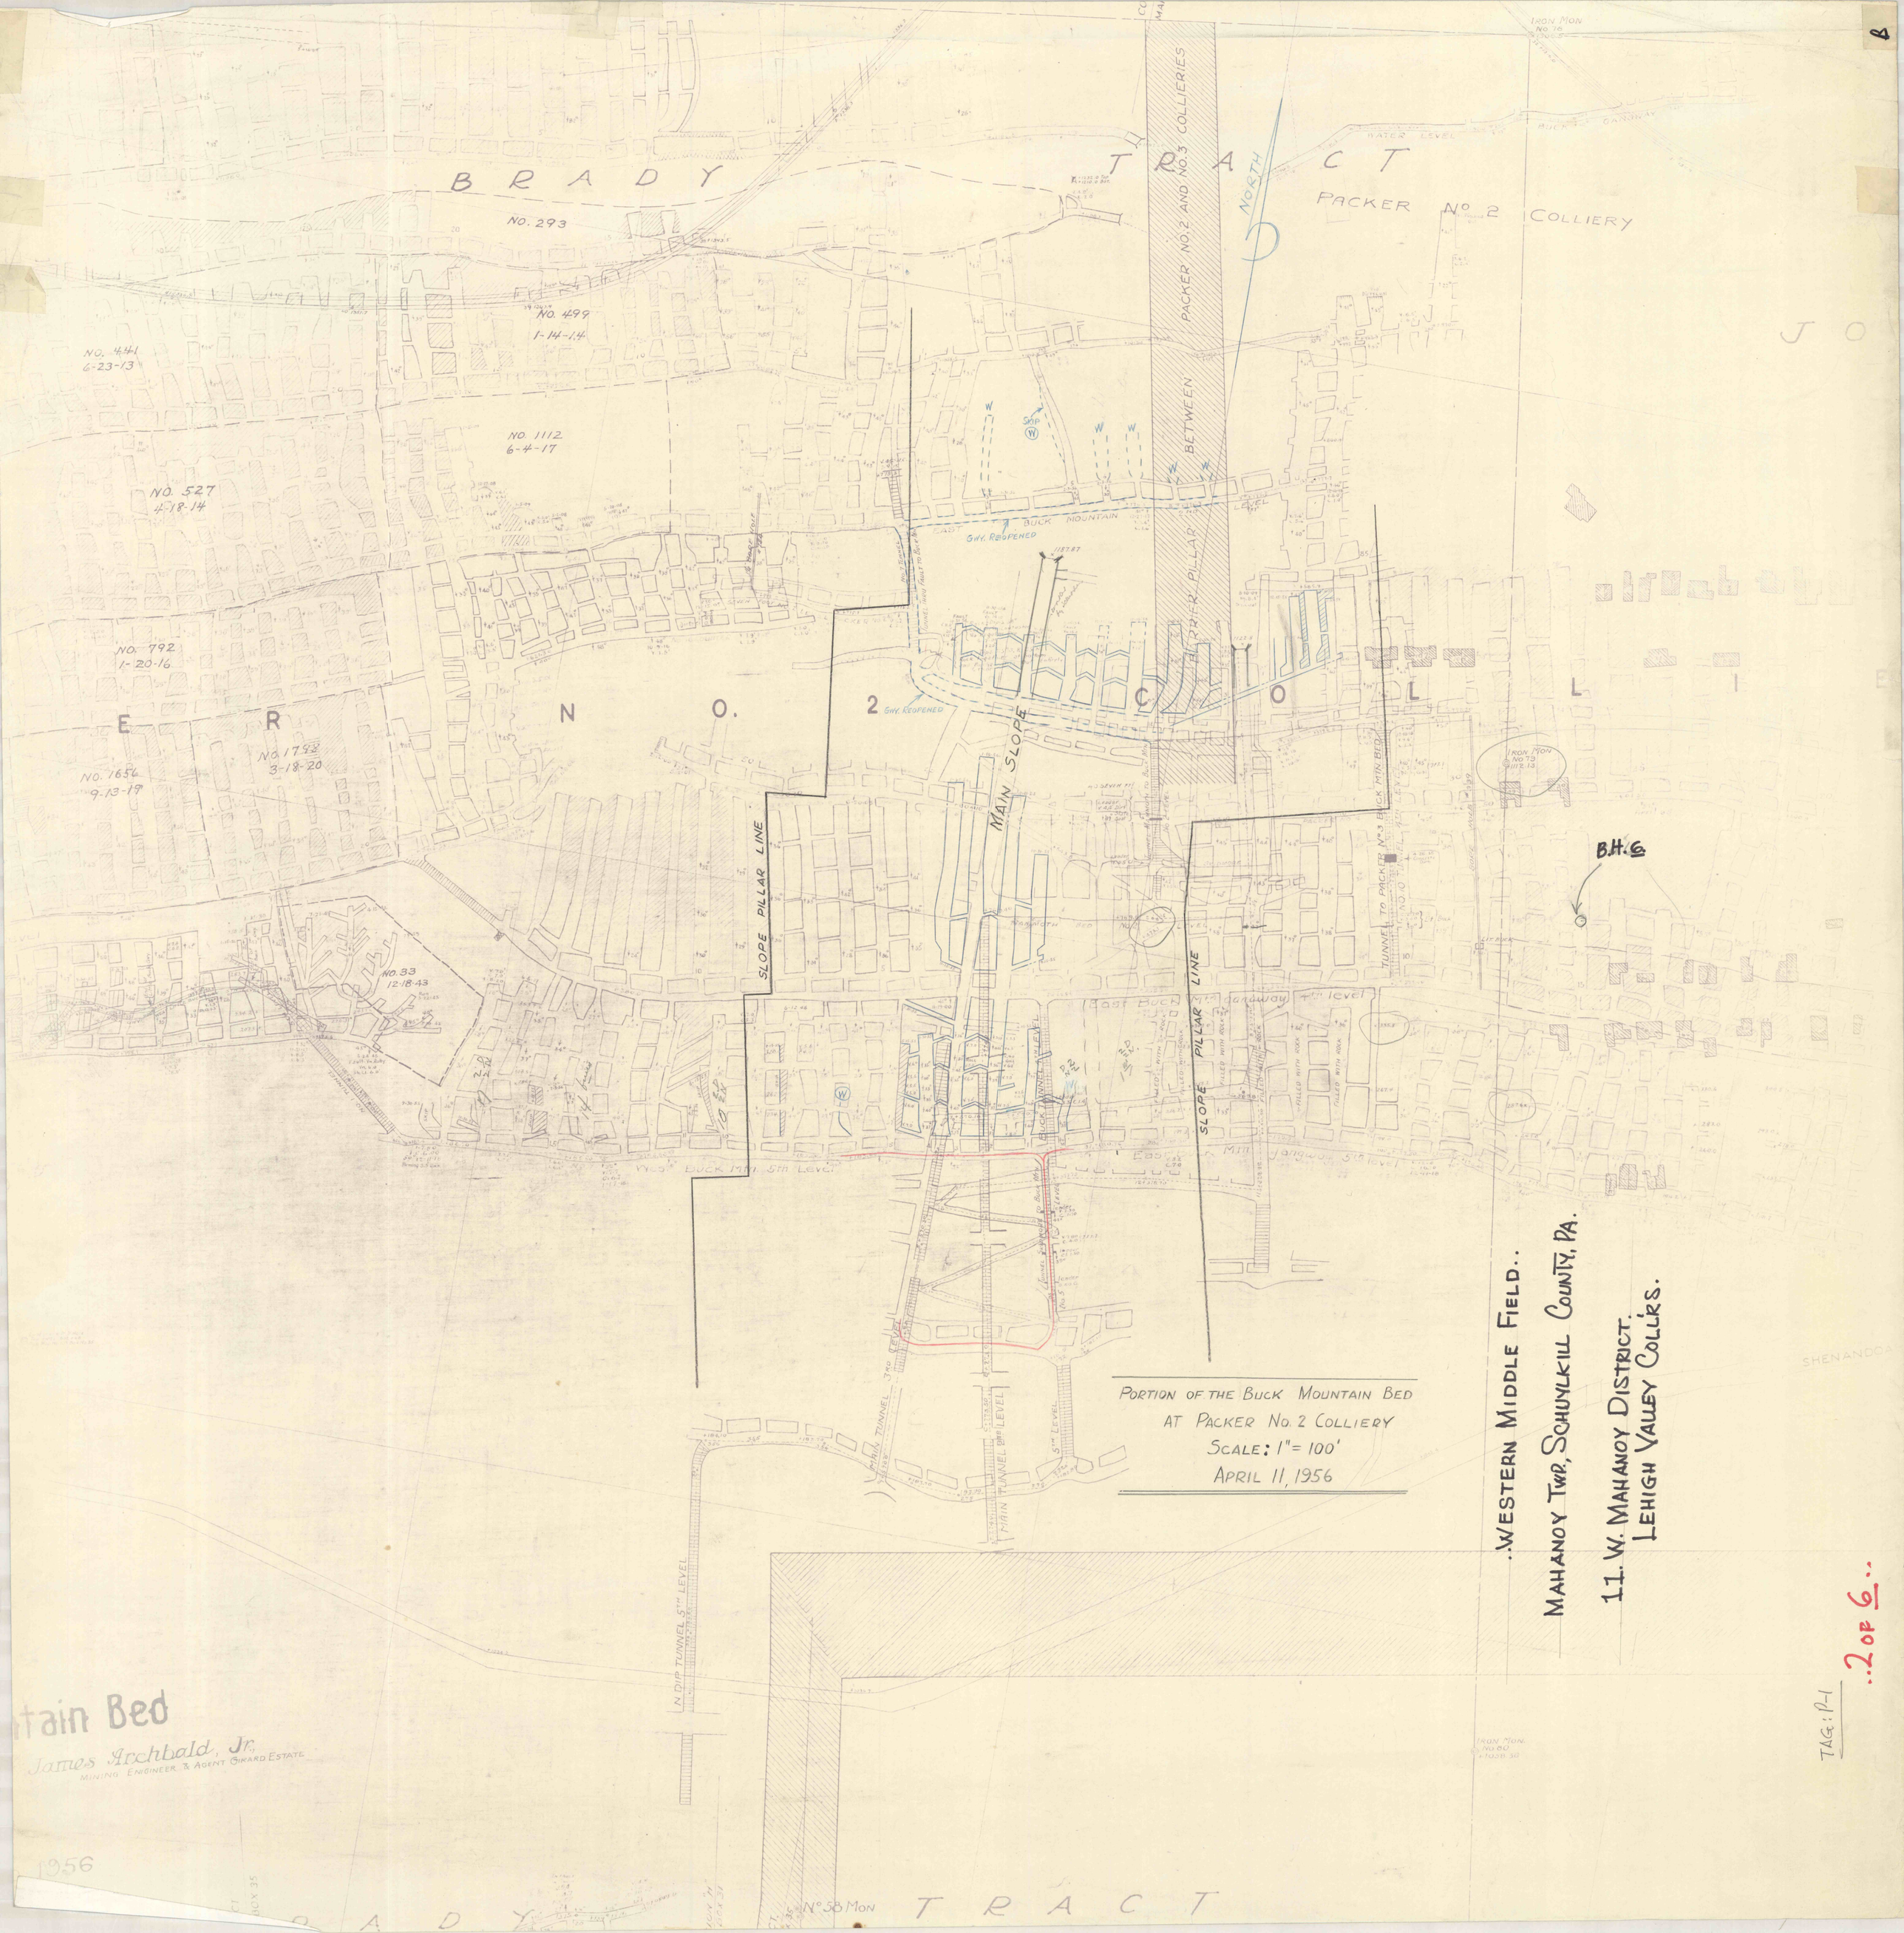

PORTION OF THE BUCK MOUNTAIN BED
AT PACKER No. 2 COLLIERY
SCALE: 1" = 100'
APRIL 11, 1956

..WESTERN MIDDLE FIELD..
MAHANOY TWP., SCHUYLKILL COUNTY, PA.
11. W. MAHANOY DISTRICT.
LEHIGH VALLEY COLLRS.

tain Bed
James Archbald, Jr.
MINING ENGINEER & AGENT GIRARD ESTATE
1956

TAG: P-1

..2 OF 6..