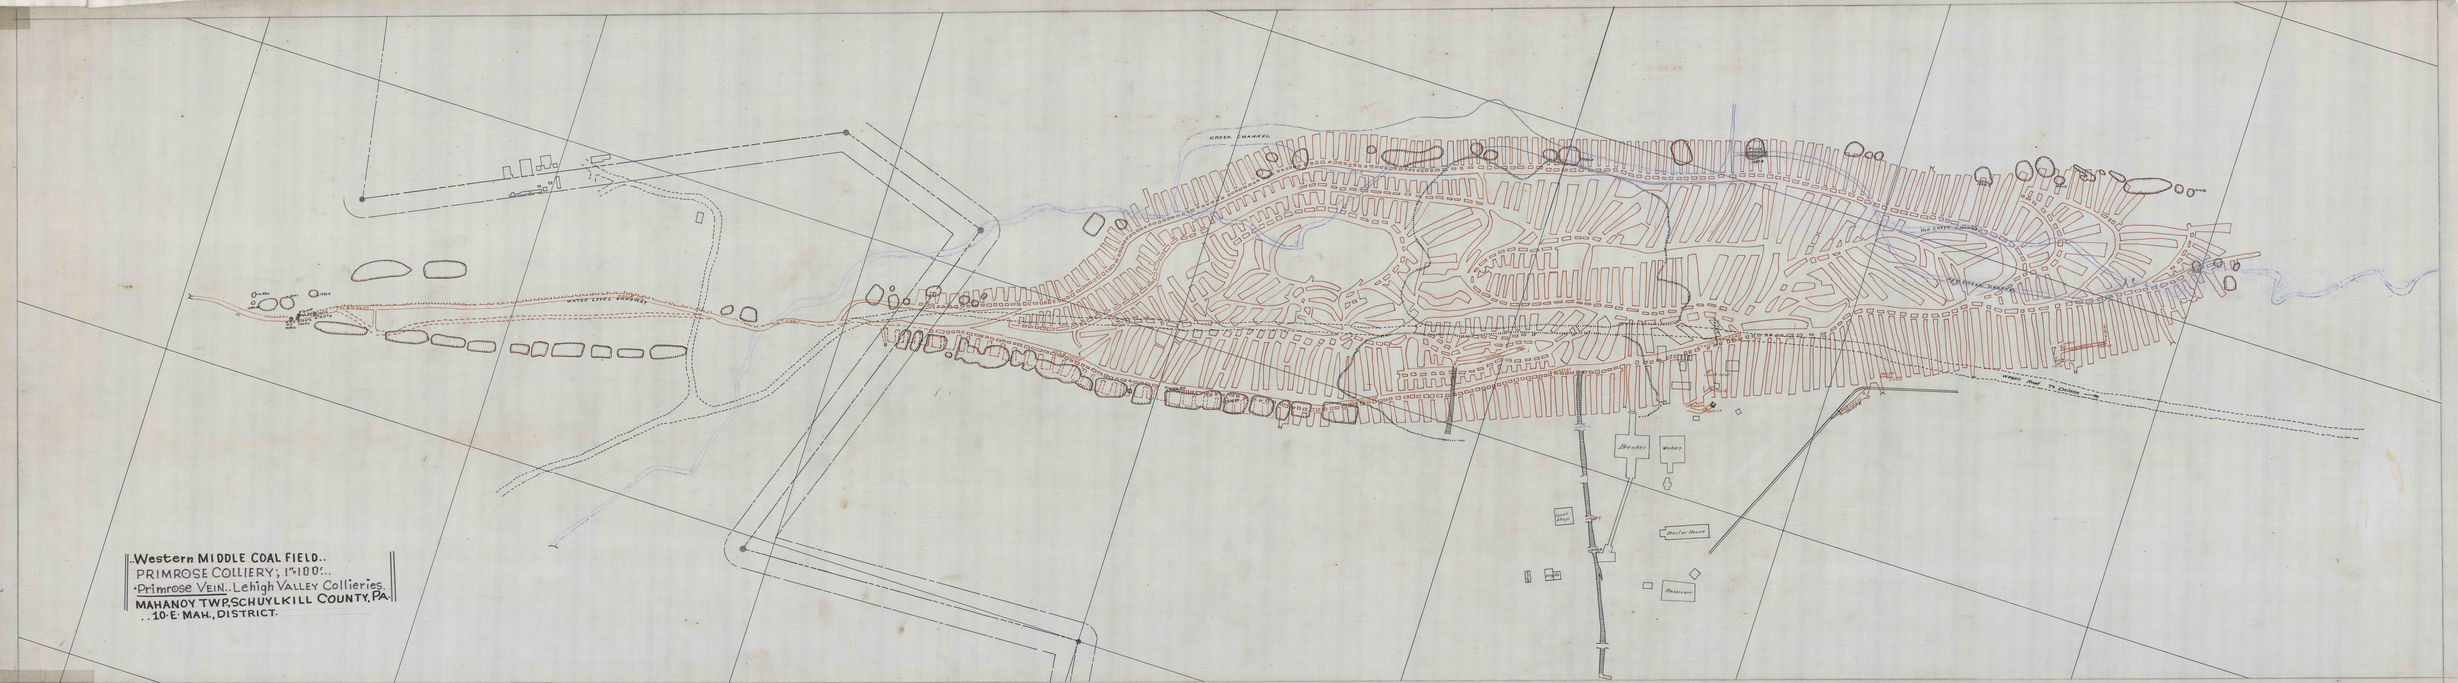


Western MIDDLE COAL FIELD..
PRIMROSE COLLIERY; 1"=100'..
Primrose VEIN. Lehigh Valley Collieries.
MAHANOY TWP. SCHUYLKILL COUNTY, PA.
..10. E. MAH., DISTRICT.

MAR 10 1972