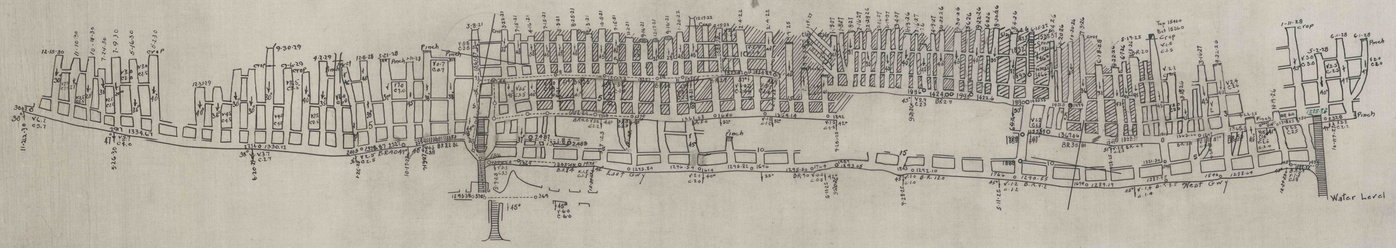

WESTERN MIDDLE FIELD
PACKER NO: 2 = COLLIERY. 1" = 100' - MAMMOTH UN.
WEST MAHANOY TWP. SCHUYLKILL COUNTY, PA.
LEHIGH VALLEY COAL CO.

NOTE: "THIS TRACING
A DOUBTFUL MAMM. UN.