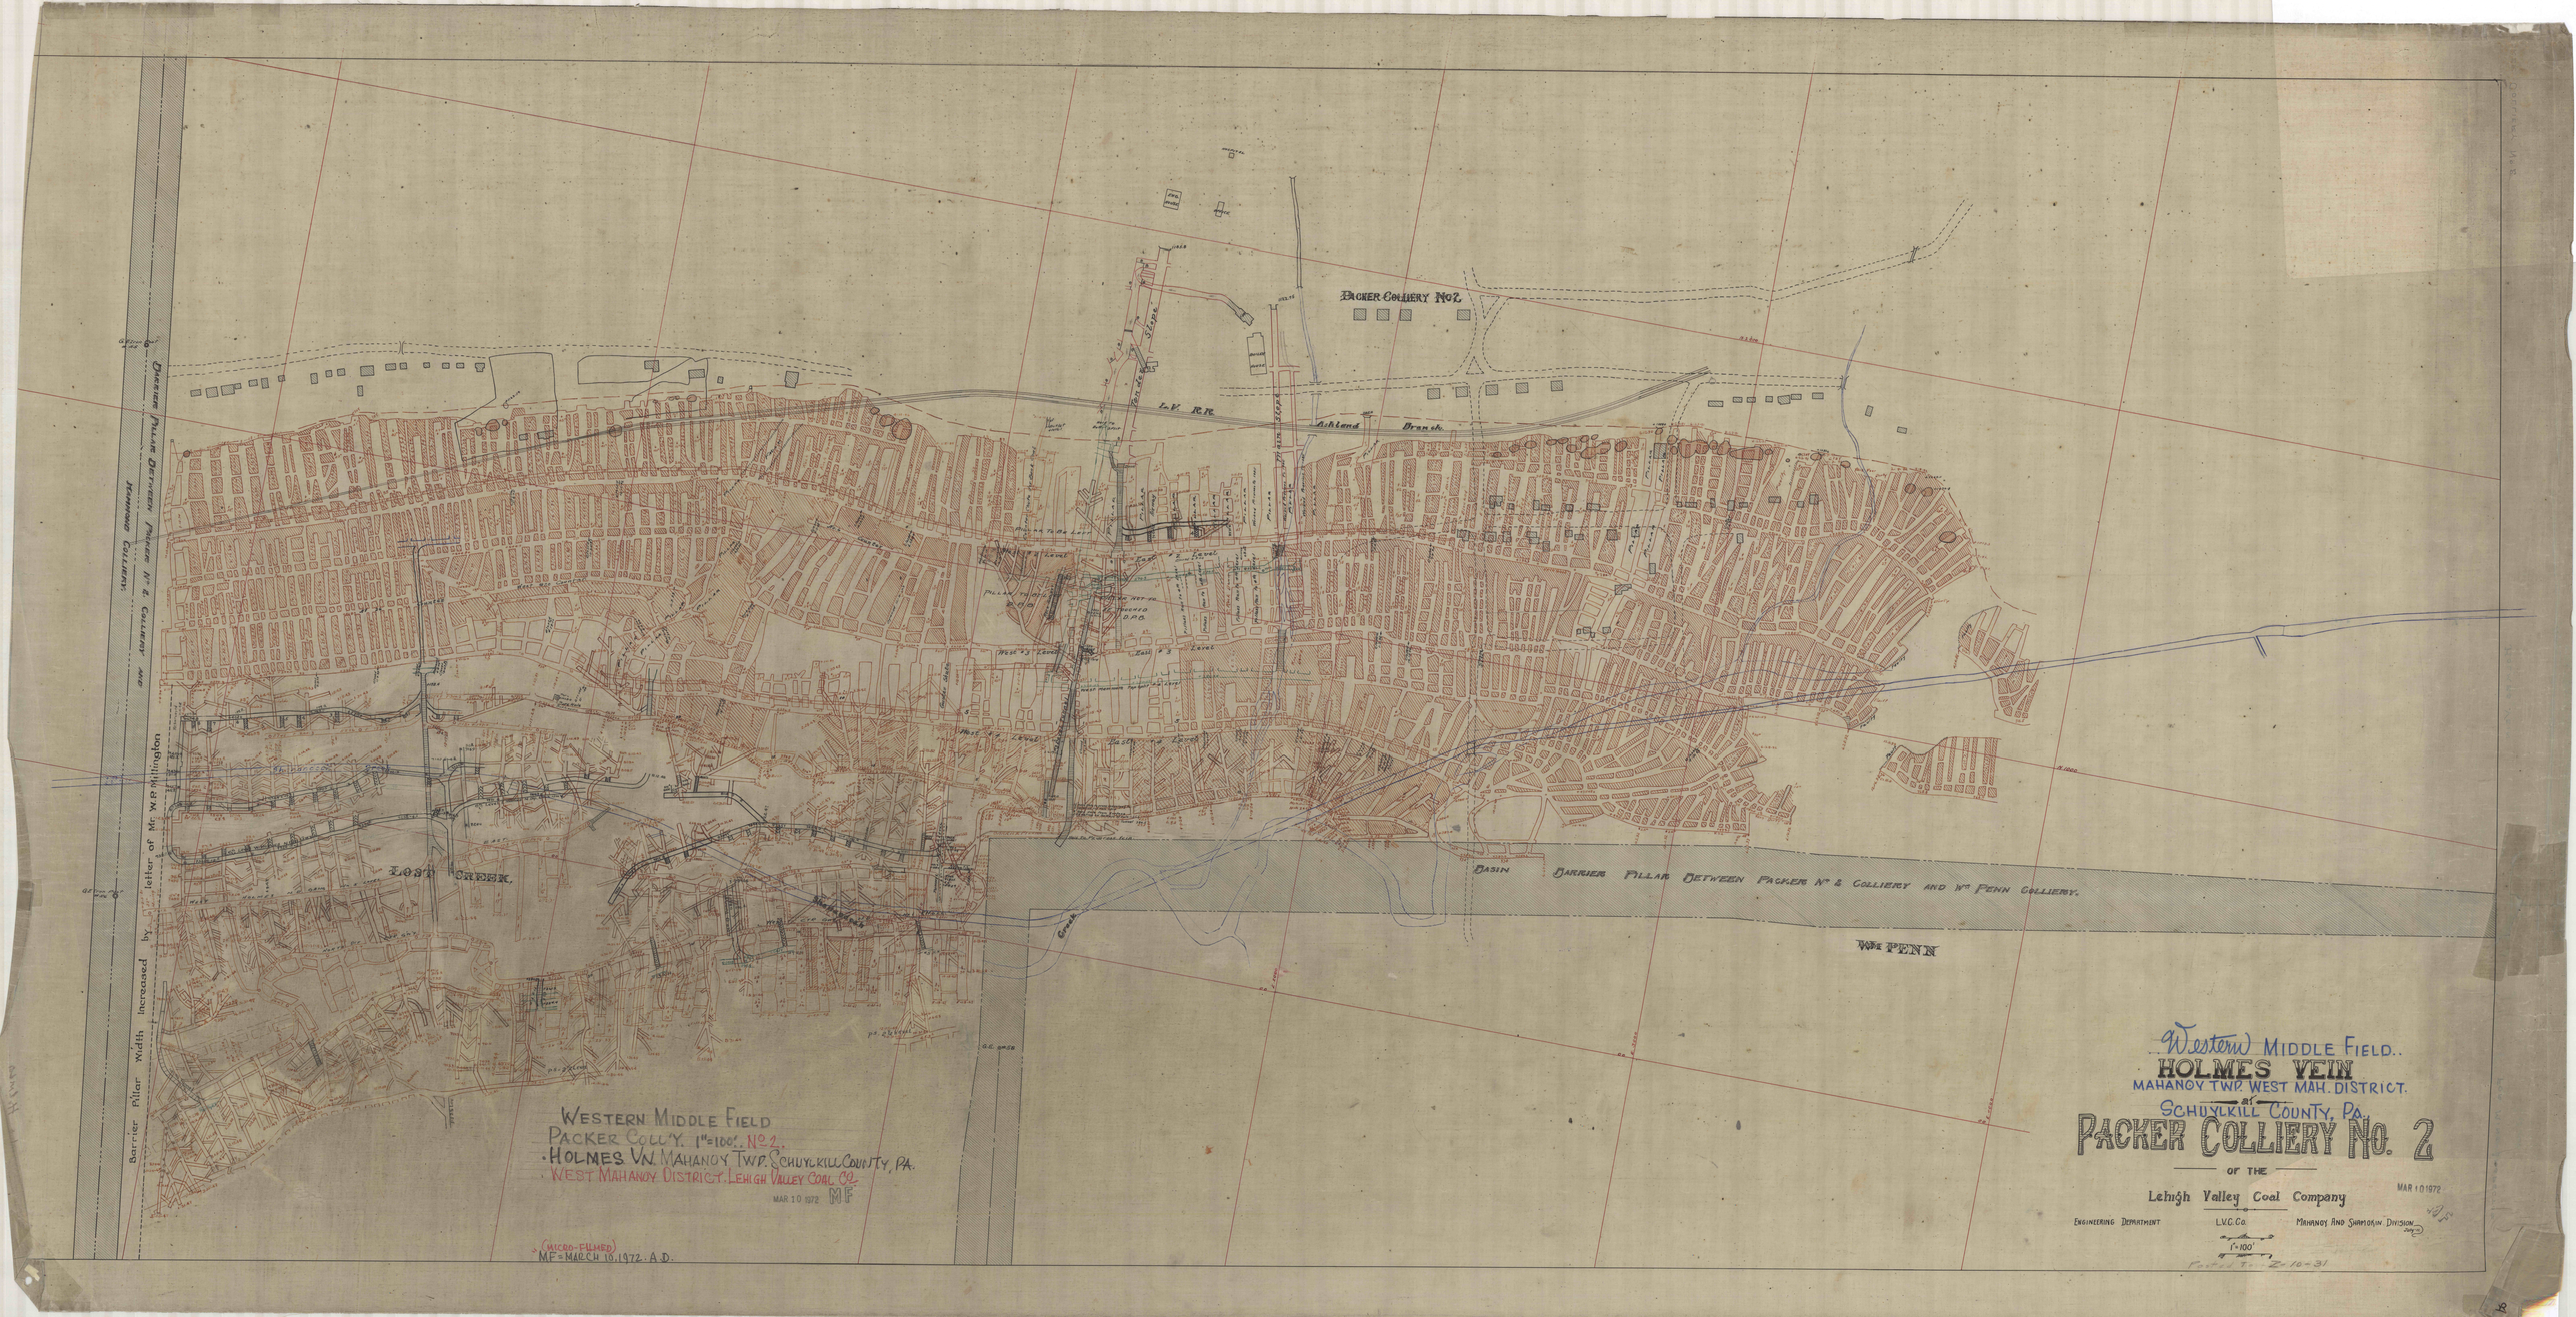

Western Middle Field
Packer Colly. 1"=100'. No 2.
Holmes Vn. Mahanoy Twp. Schuylkill County, Pa.
West Mahanoy District. Lehigh Valley Coal Co.
MAR 10 1972 MF

(Micro-Filmed)
MF-March 10, 1972 A.D.

Western Middle Field.
HOLMES VEIN
Mahanoy Twp. West Mah. District.
of
Schuylkill County, Pa.
Packer Colliery No. 2
or the
Lehigh Valley Coal Company
MAR 10 1972
Engineering Department L.V.C. Co. Mahanoy and Shamokin Division
1"=100'
Packer No. 2 - Z-10-31