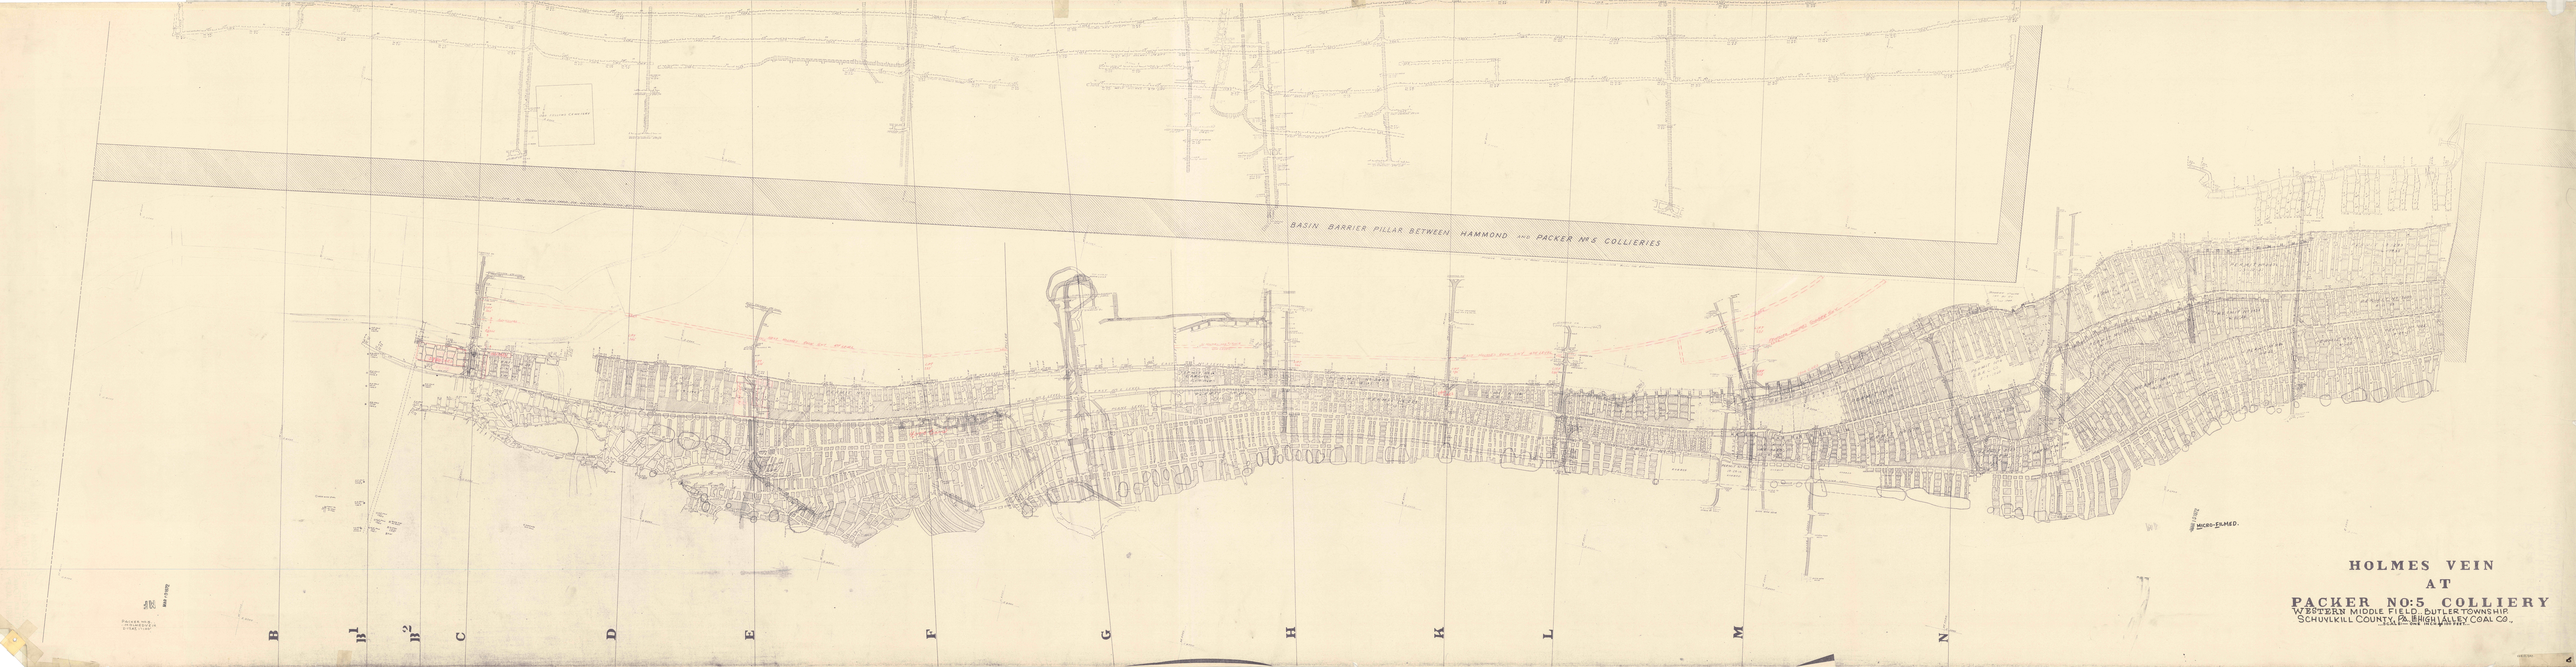

BASIN BARRIER PILLAR BETWEEN HAMMOND AND PACKER Nos 5 COLLIERIES
B
B1
B2
C
D
E
F
G
H
K
L
M
N
HOLMES VEIN
AT
PACKER NO:5 COLLIERY
WESTERN MIDDLE FIELD, BUTLER TOWNSHIP
SCHUYLKILL COUNTY, PA. LEHIGH VALLEY COAL CO.