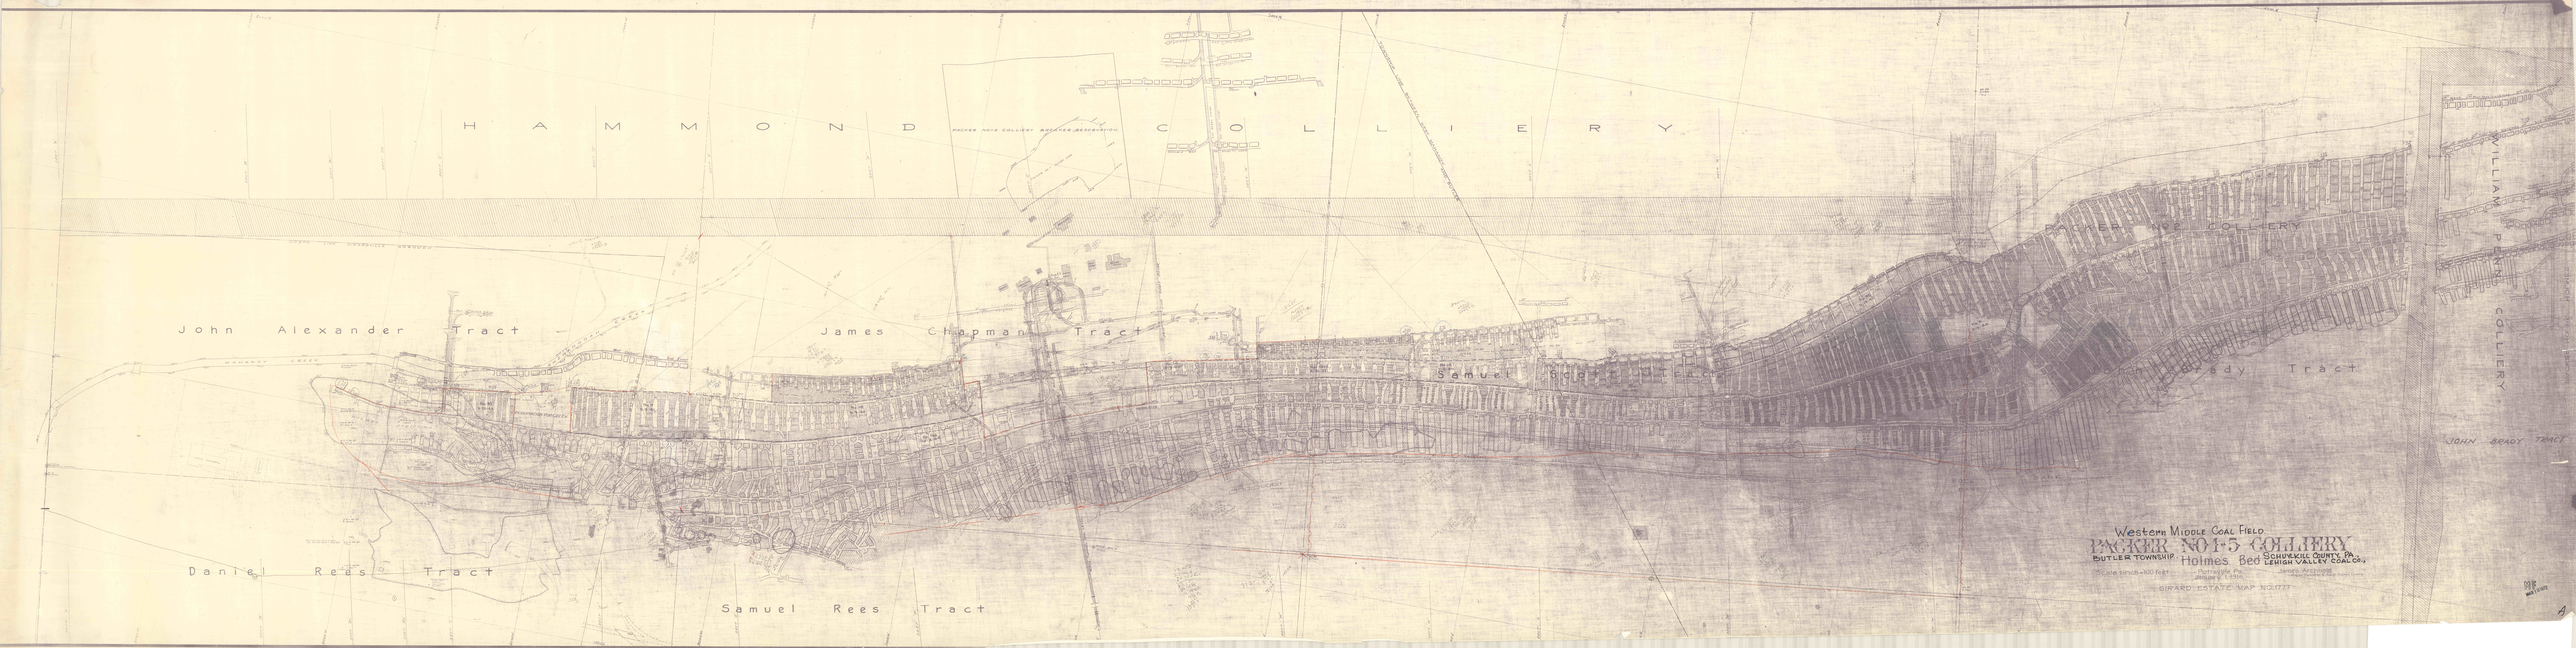
H A M M O N D
PACKER NO 5 COLLIERY
C O L L I E R Y
John Alexander Tract
James Chapman Tract
Samuel Rees Tract
Daniel Rees Tract
Samuel Rees Tract
PACKER NO 5 COLLIERY
WILLIAM PENN COLLIERY
JOHN BRADY TRACT
Western Middle Coal Field
PACKER NO 5 COLLIERY
BUTLER TOWNSHIP, SCHUYLKILL COUNTY, PA.
Holmes Bed LEHIGH VALLEY COAL CO.
GIRARD ESTATE MAP NO 177