


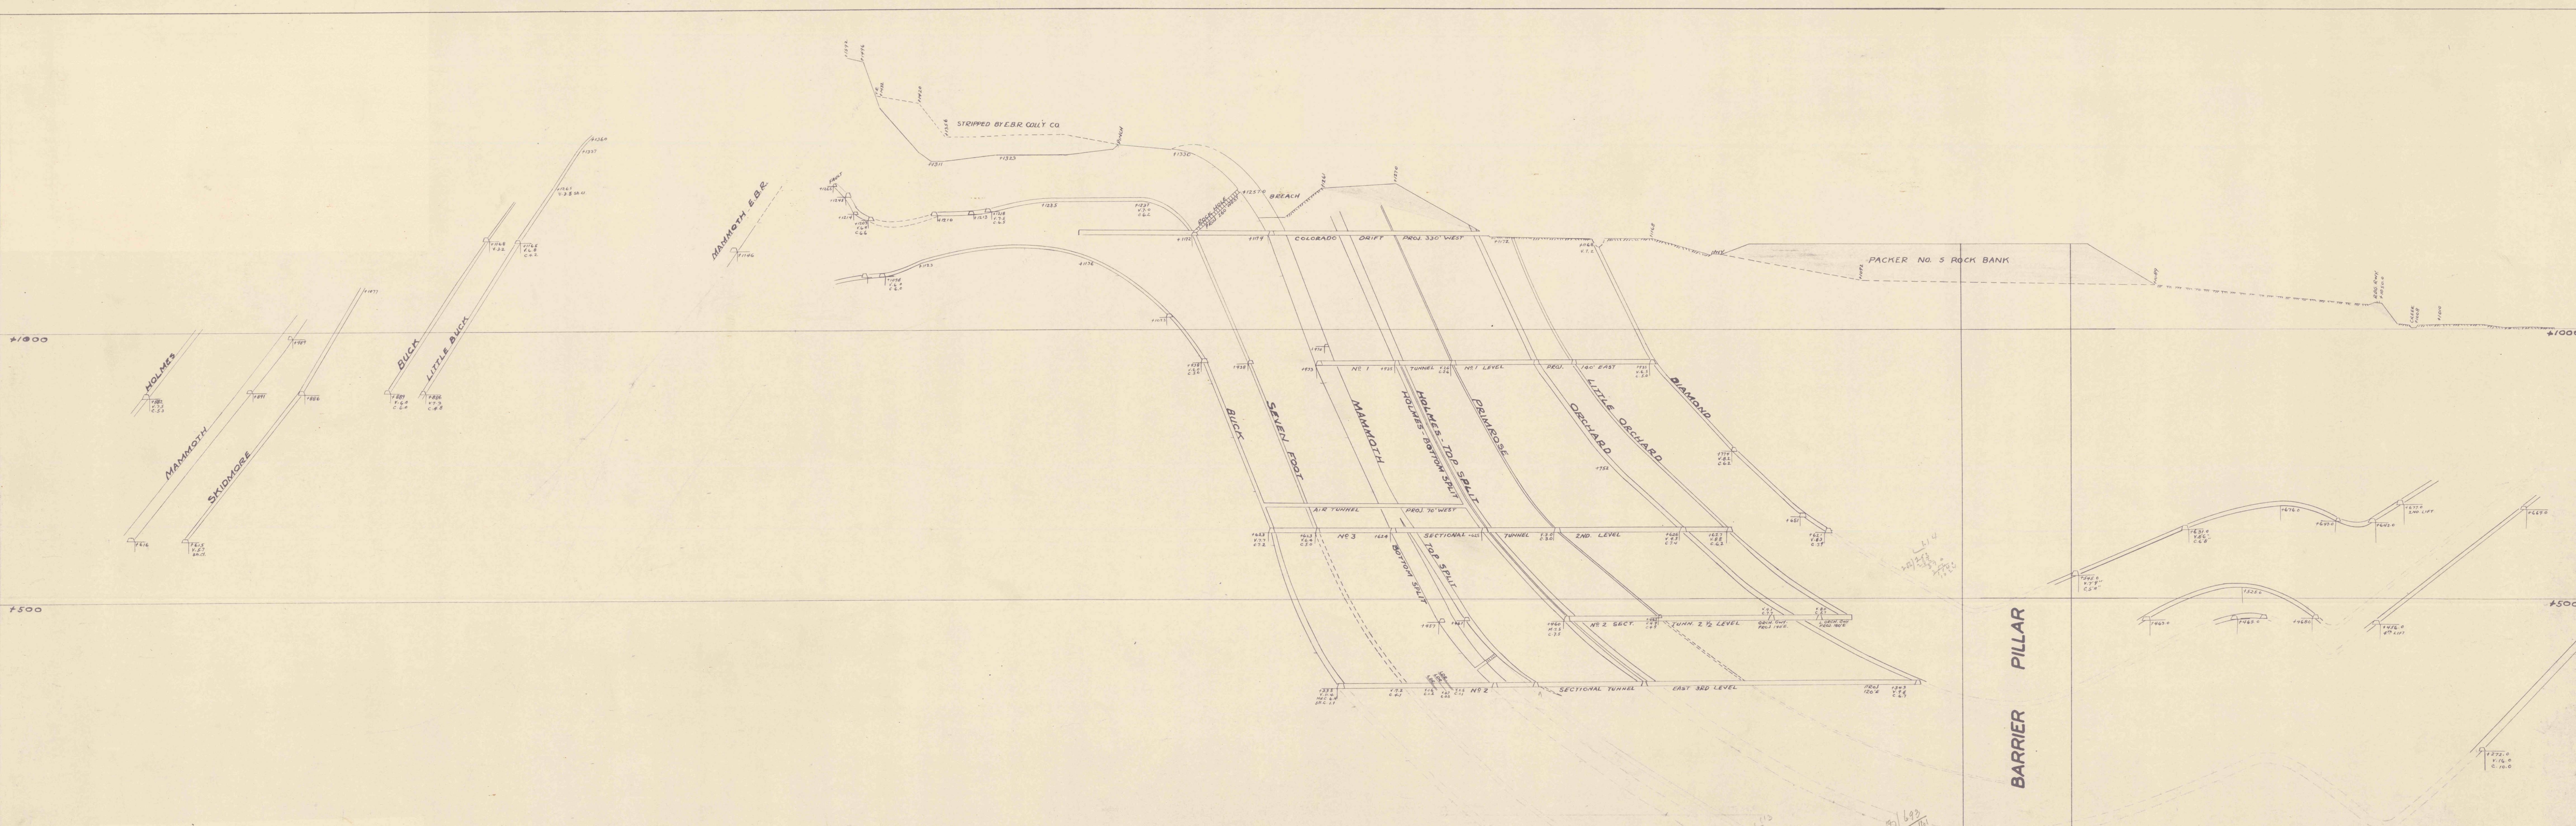

WEST BEAR RIDGE COLLIERY Packer No. 5 COLLIERY HAMMOND COLLIERY

WESTERN MIDDLE FIELD. PACKER NO. 5 COLLIERY. "SECTION-LINE-M" (LOOKING WEST),
THROUGH NO. 3-SECTIONAL-TUNNEL-NO. 2-LEVEL
Butler Twp., Schuylkill County, Pa., & NO. 2-SECTIONAL-TUNNEL-NO. 3-LEVEL
11 W. MAHANOEY DISTRICT. LEHIGH VALLEY COLLIERIES. 3650-FT.-EAST-OF-THE-SHAFT.
SCALE: 1" = 100'