


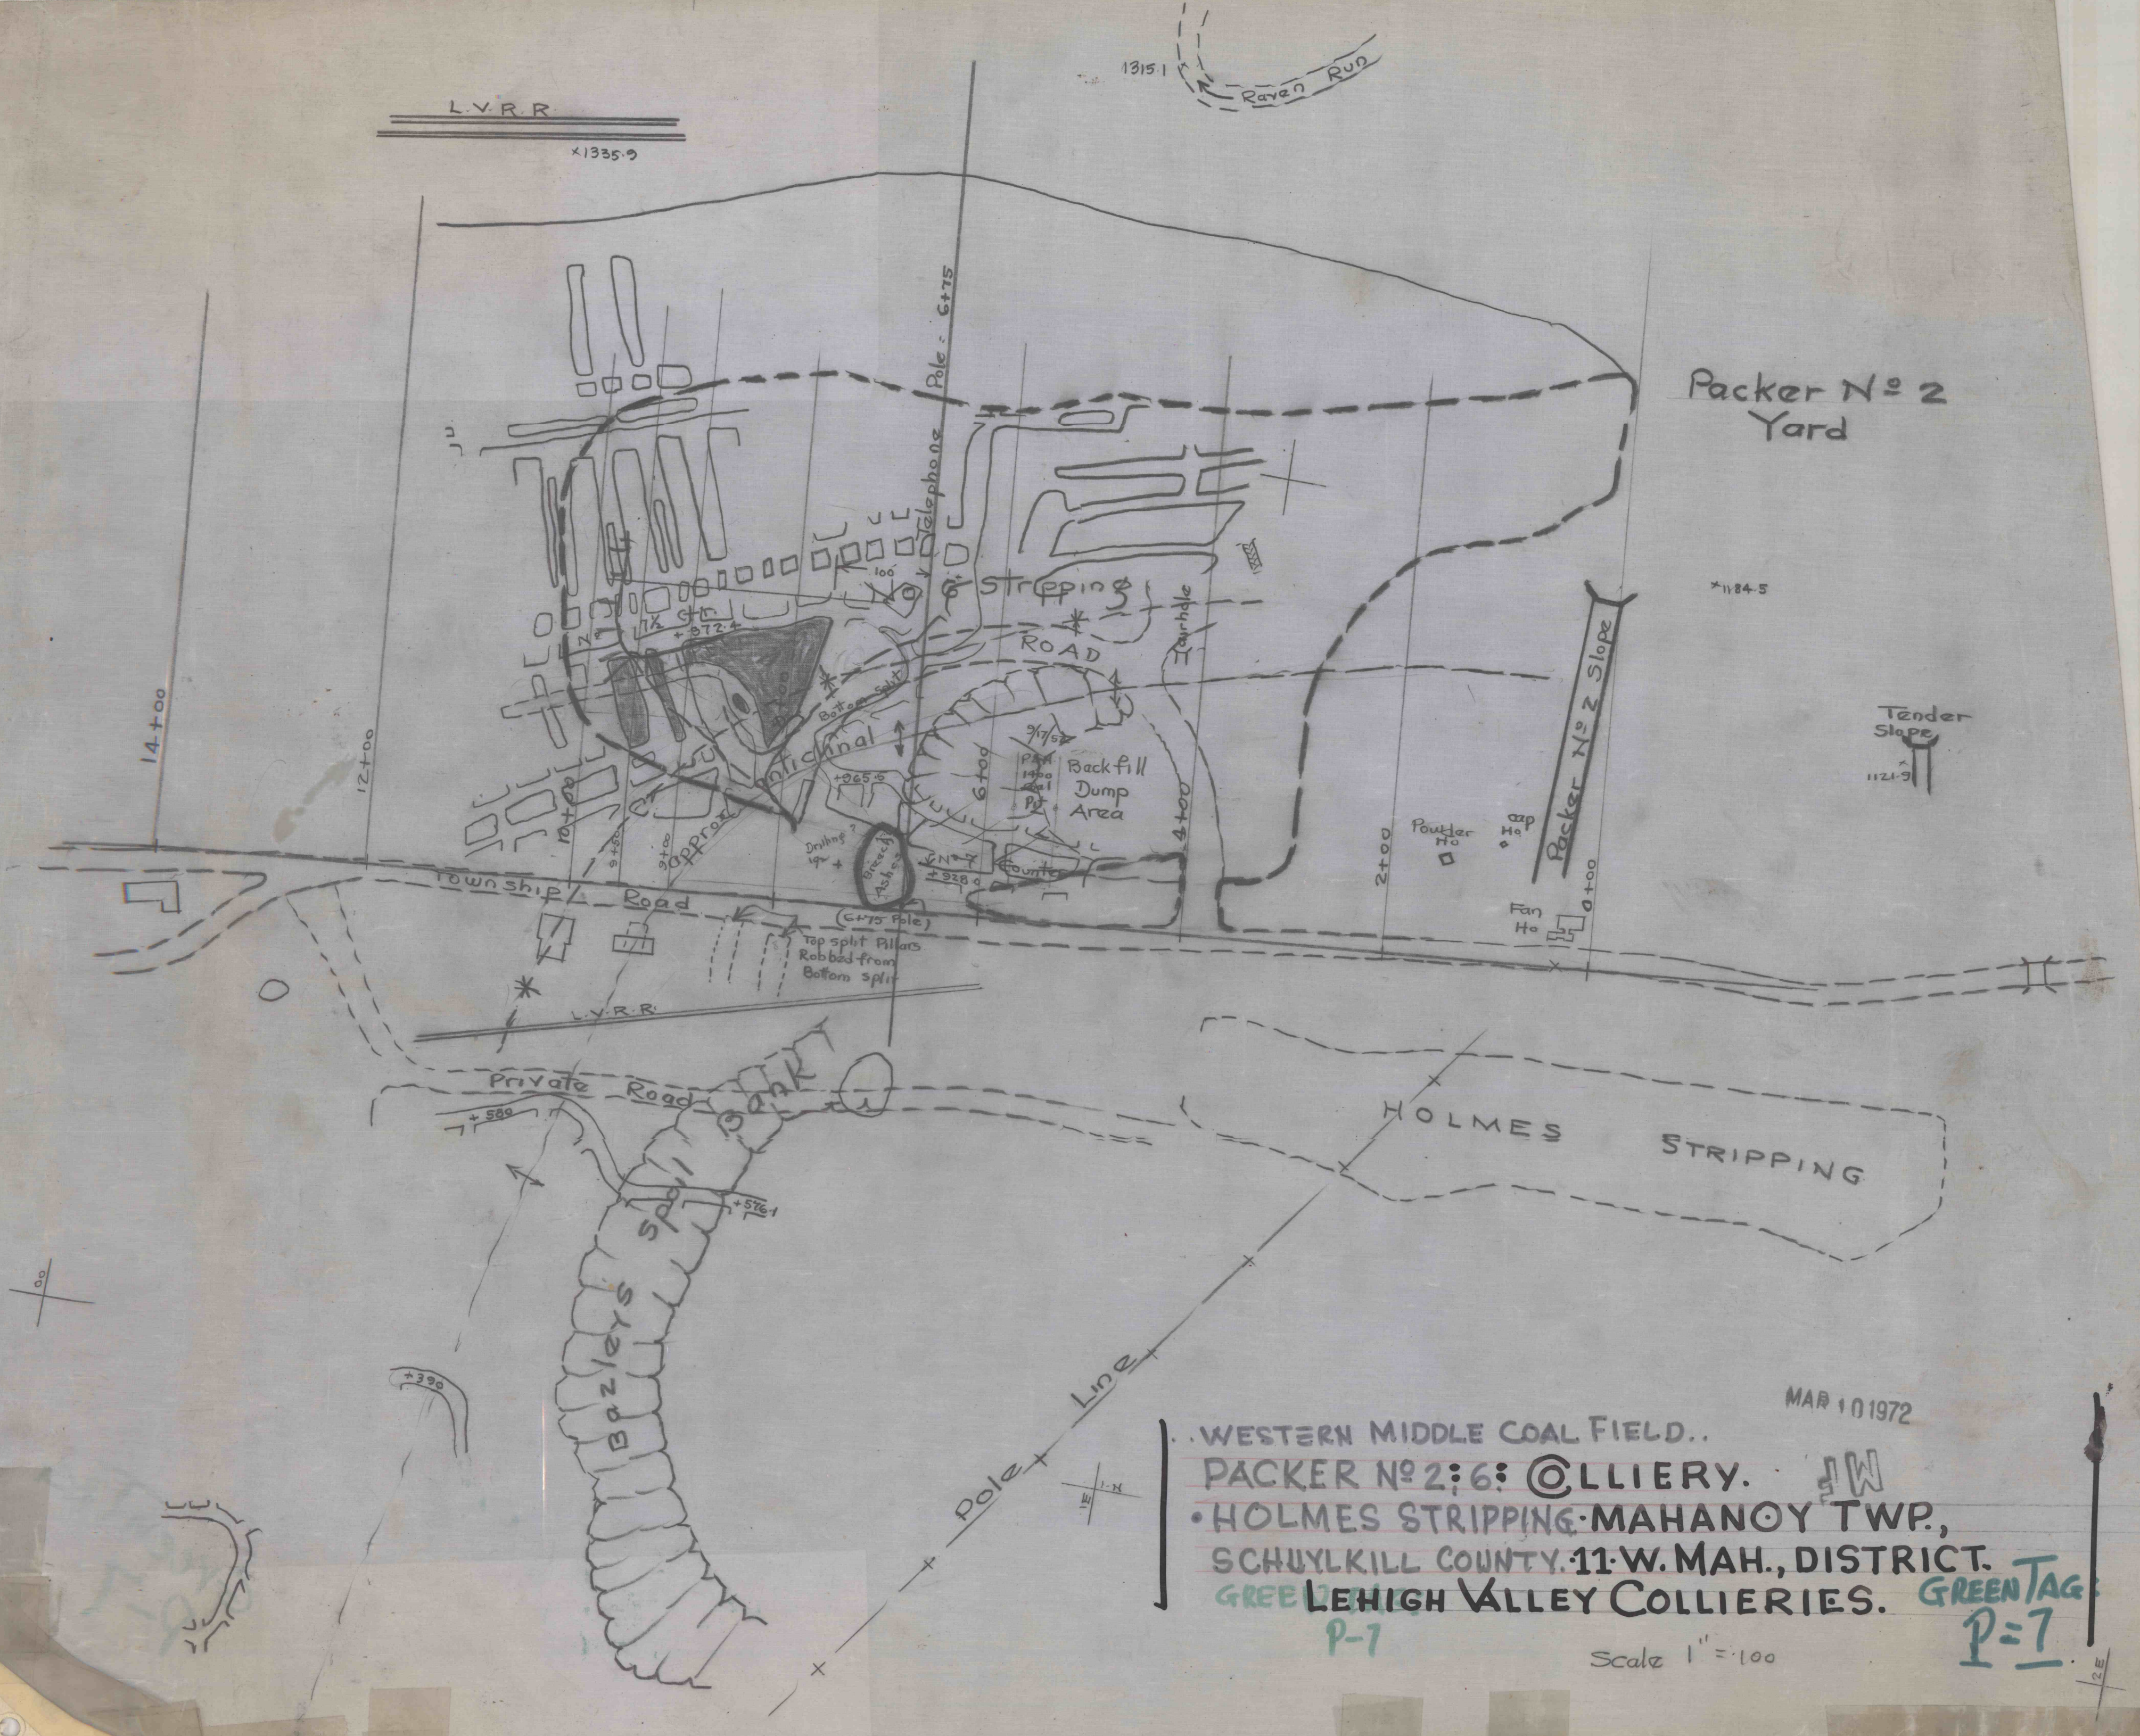

MAR 10 1972

WESTERN MIDDLE COAL FIELD..
PACKER No 2:6: COLLIERY.
• HOLMES STRIPPING MAHANOEY TWP.,
SCHUYLKILL COUNTY. 11 W. MAH., DISTRICT.
GREEN LEHIGH VALLEY COLLIERIES. GREEN TAG
P-7

Scale 1" = 100