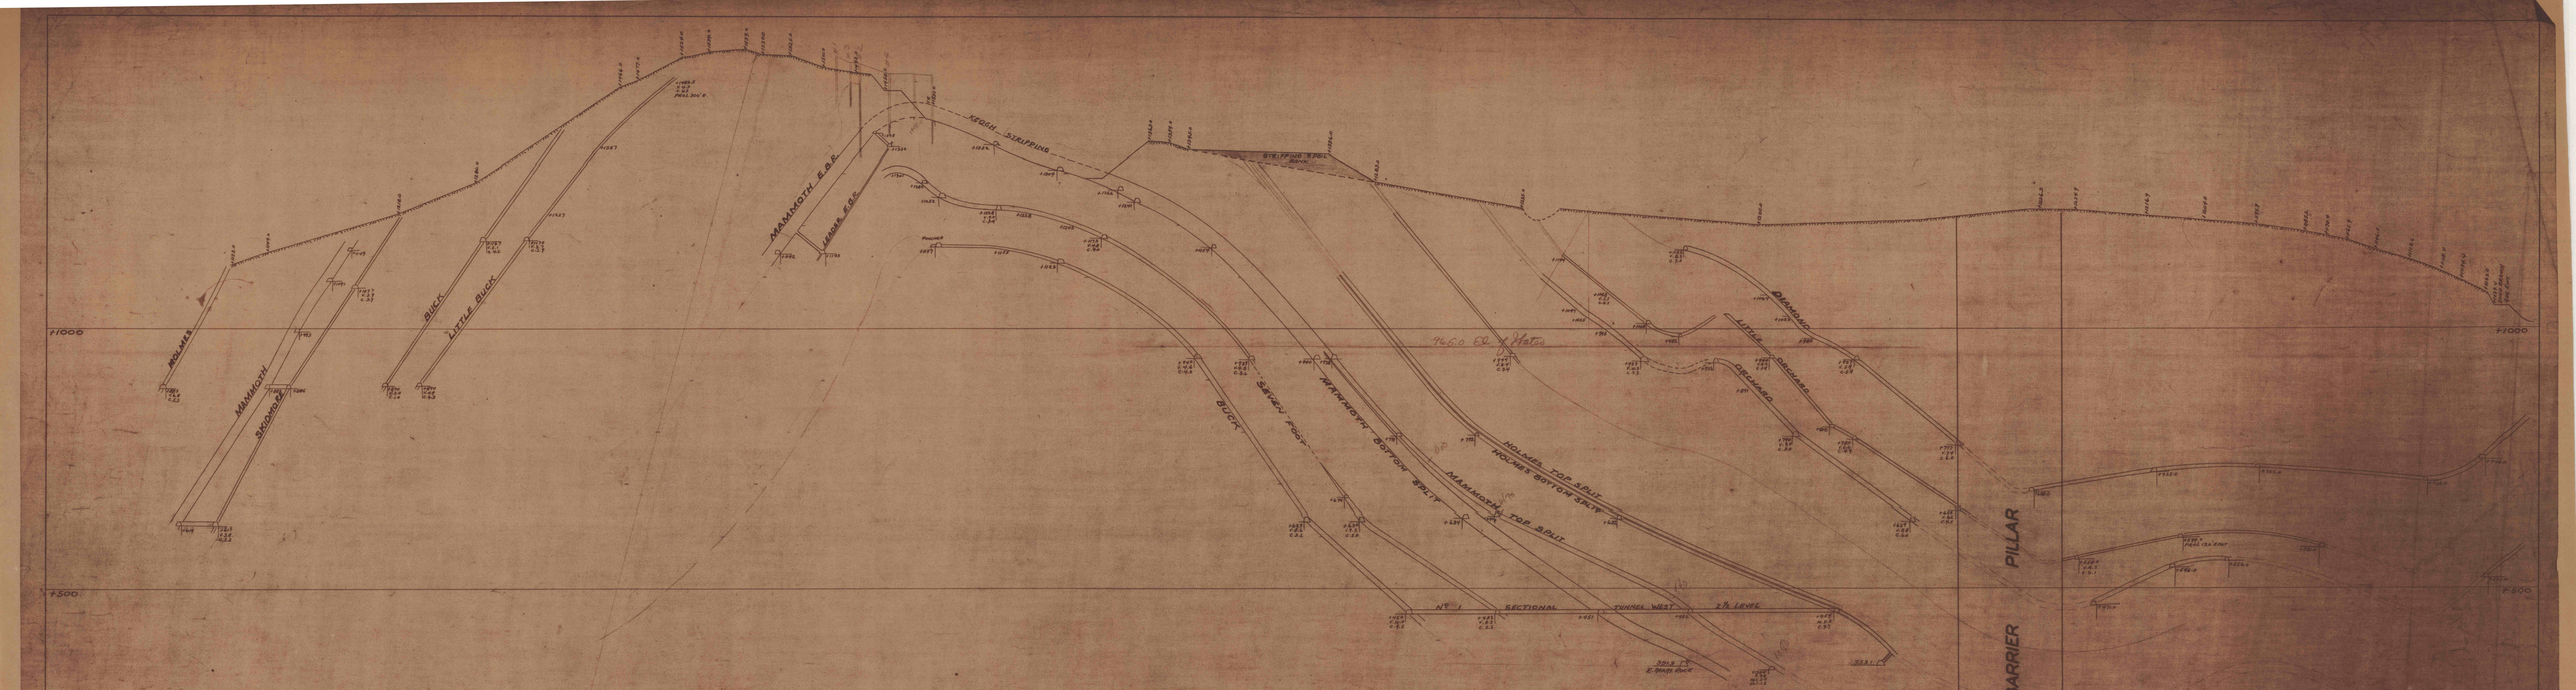

WEST BEAR RIDGE COLLIERY

PACKER NO. 5 COLLIERY

HAMMOND COLLIERY

SECTION LINE "N" (LOOKING WEST)
THROUGH NO. 1 SECTIONAL TUNNEL WEST 2½ LEVEL
175 FT. WEST OF BARRIER PILLAR
4750 FEET EAST OF THE SHAFT
SCALE 1" = 100'

"N"