


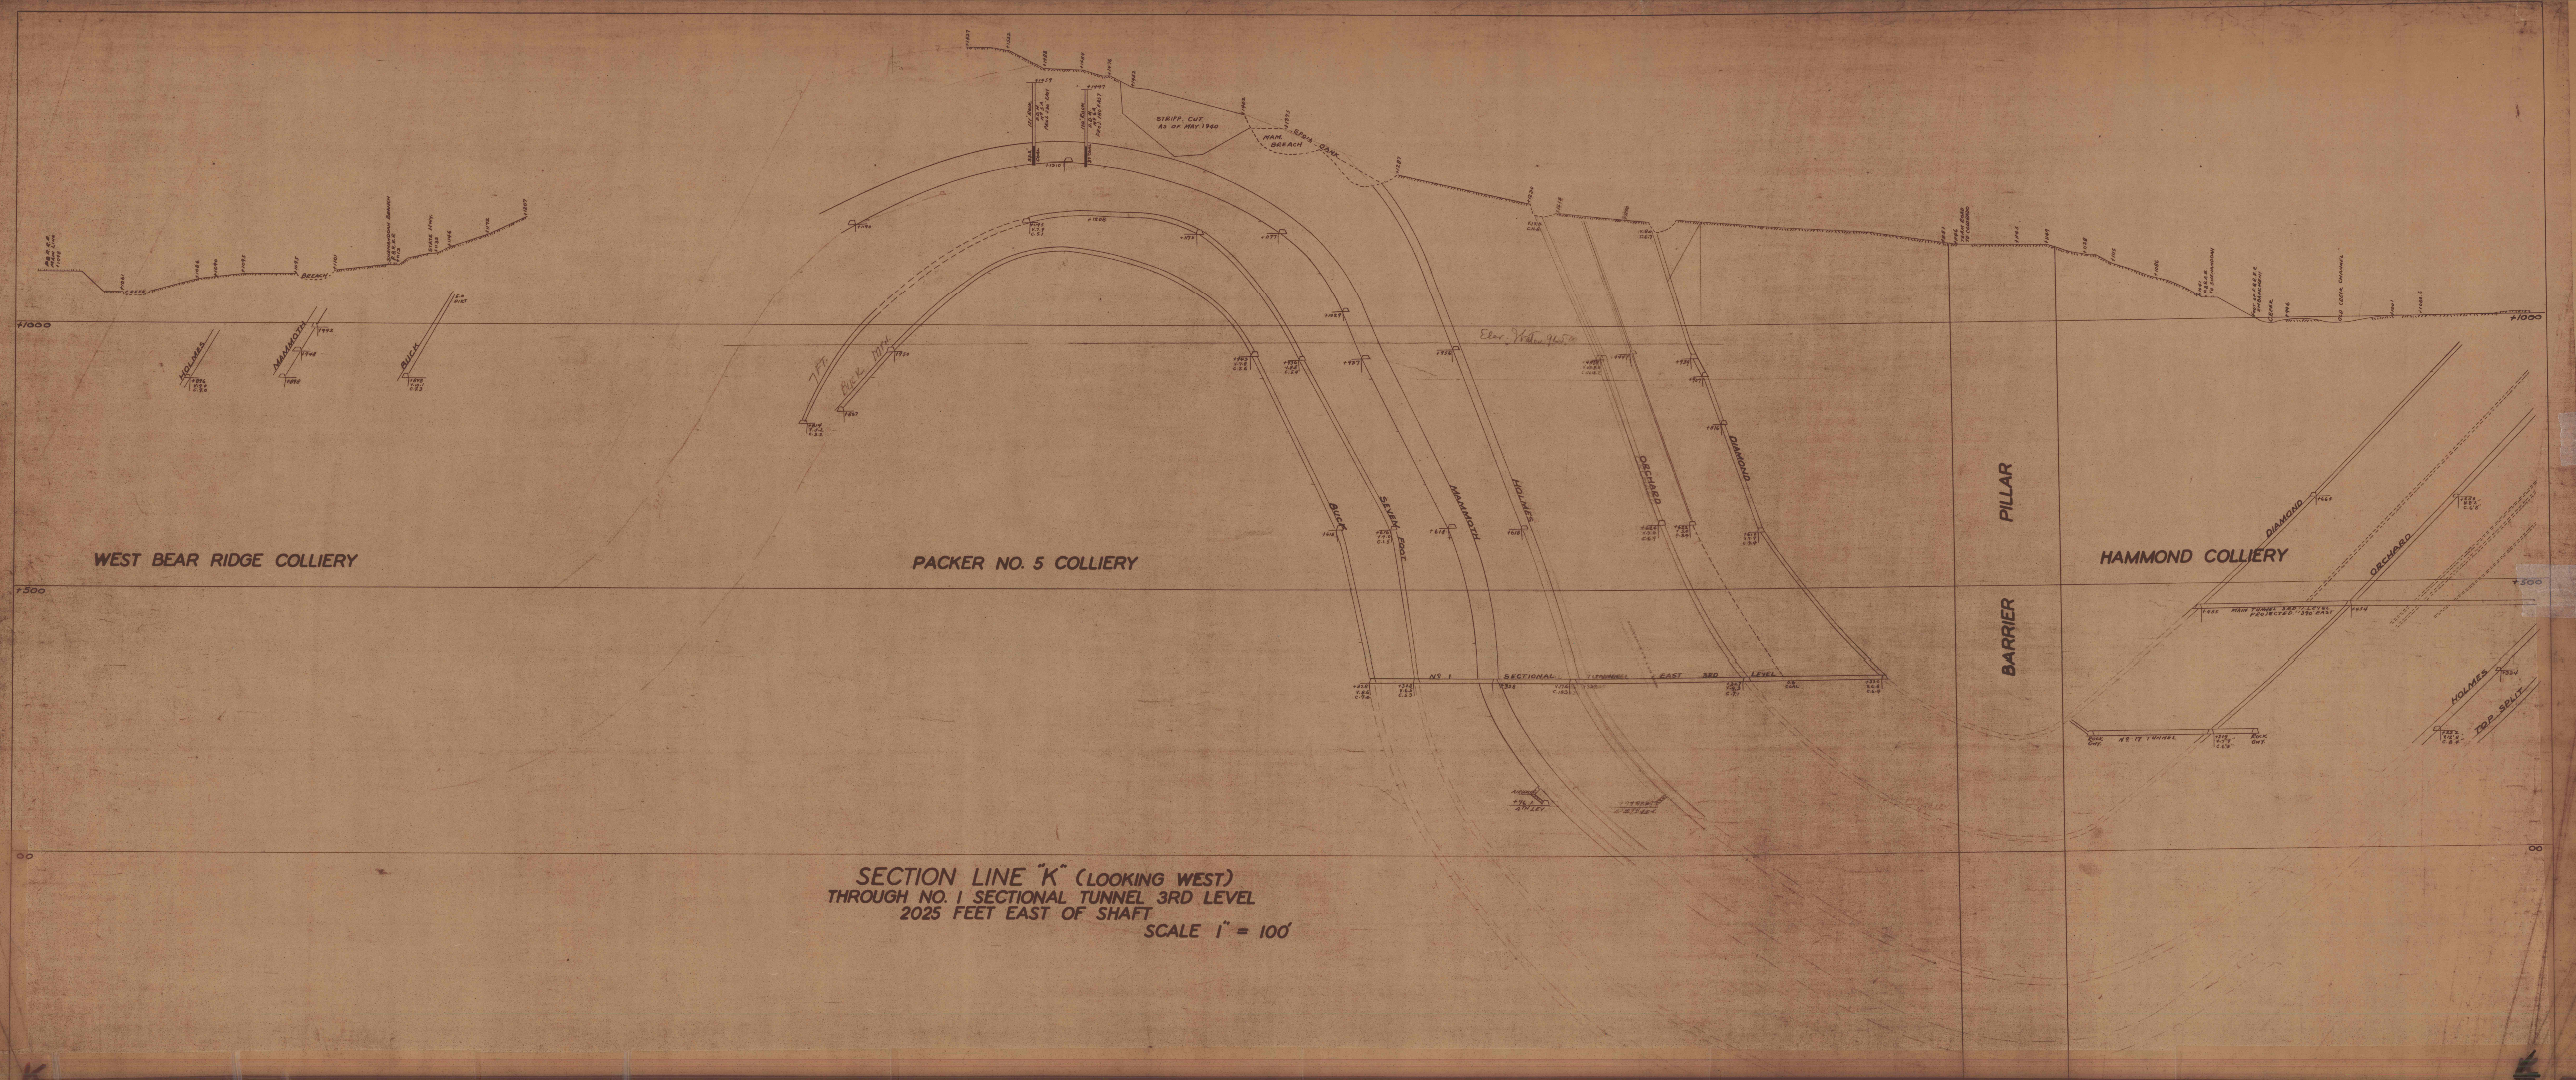

SECTION LINE "K" (LOOKING WEST)
THROUGH NO. 1 SECTIONAL TUNNEL 3RD LEVEL
2025 FEET EAST OF SHAFT
SCALE 1" = 100'