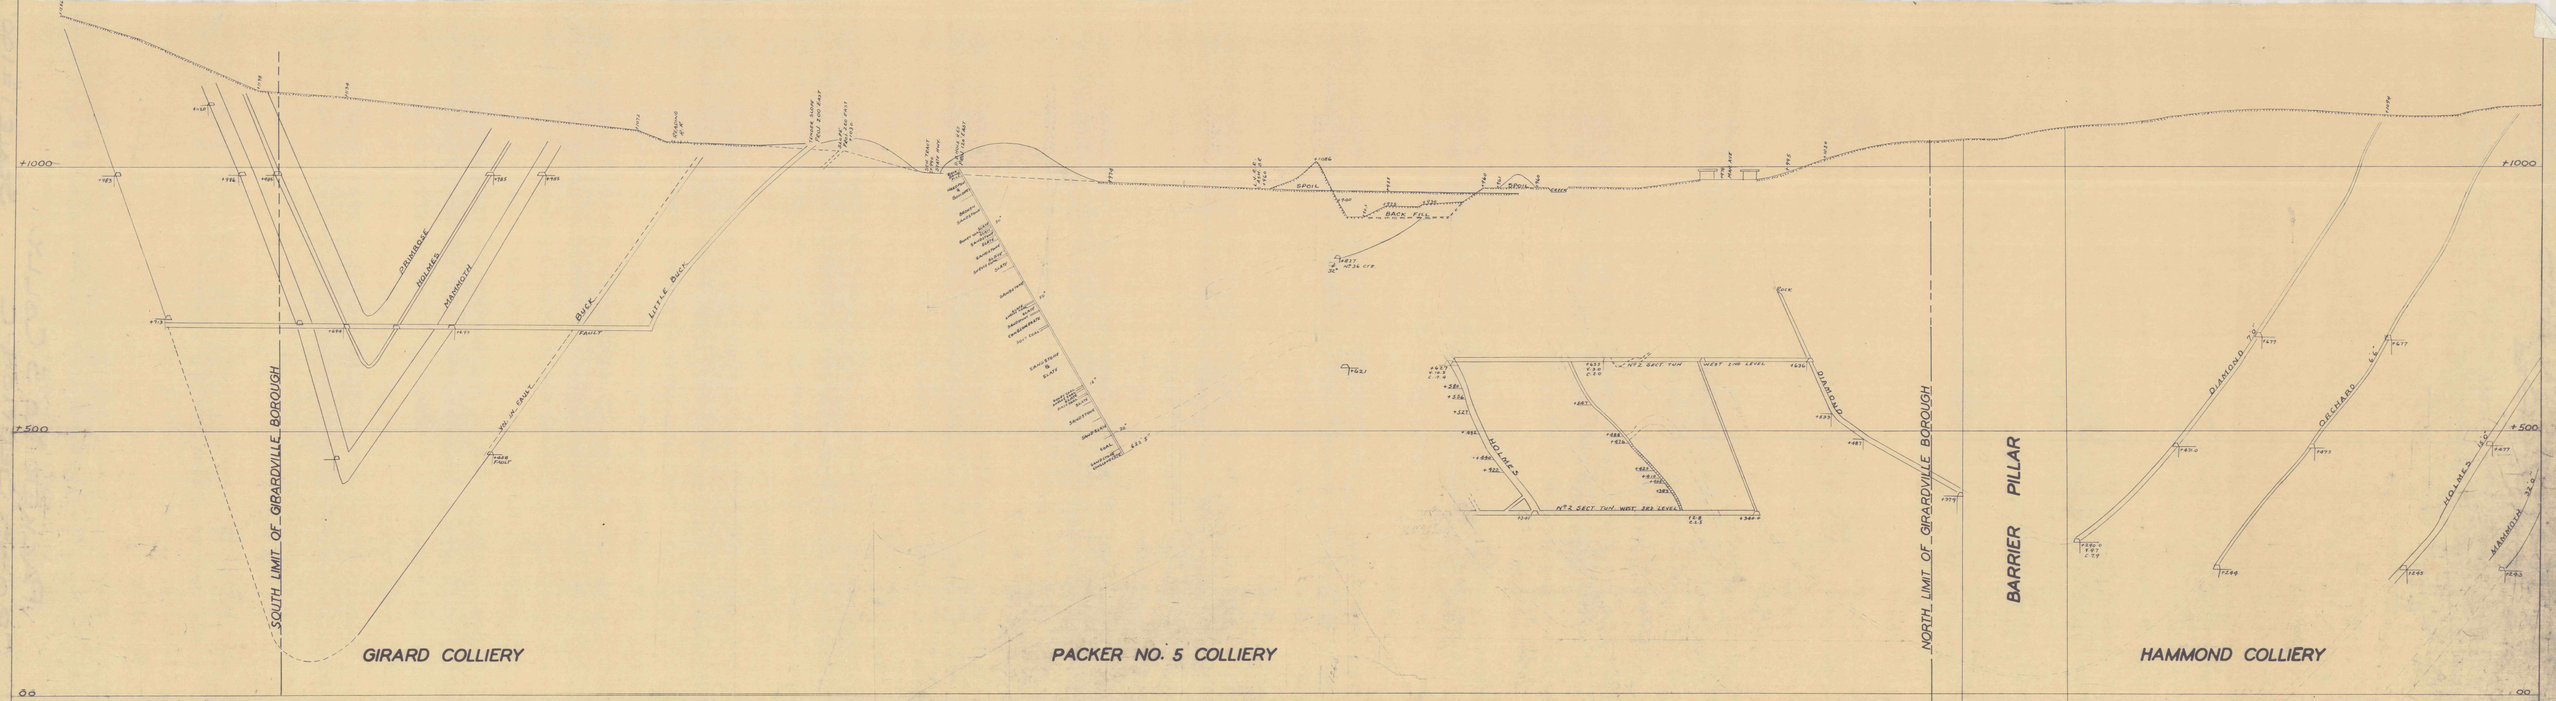

WESTERN Middle Field. Packer#5 Colliery. "SECTION-LINE-"C"-(LOOKING WEST)
THROUGH-NO: 2-SECTIONAL-TUNNEL-NO: 2-LEVEL
& NO: 2-SECTIONAL-TUNNEL-NO: 3-LEVEL
3300-FT.-WEST-OF-THE-SHAFT."

Butler Twp., Schuylkill County, PA.,

11-W. Mahanoy Dist., Lehigh Valley Collieries.

SCALE: 1" = 100'

MAR 10 1972
MF