


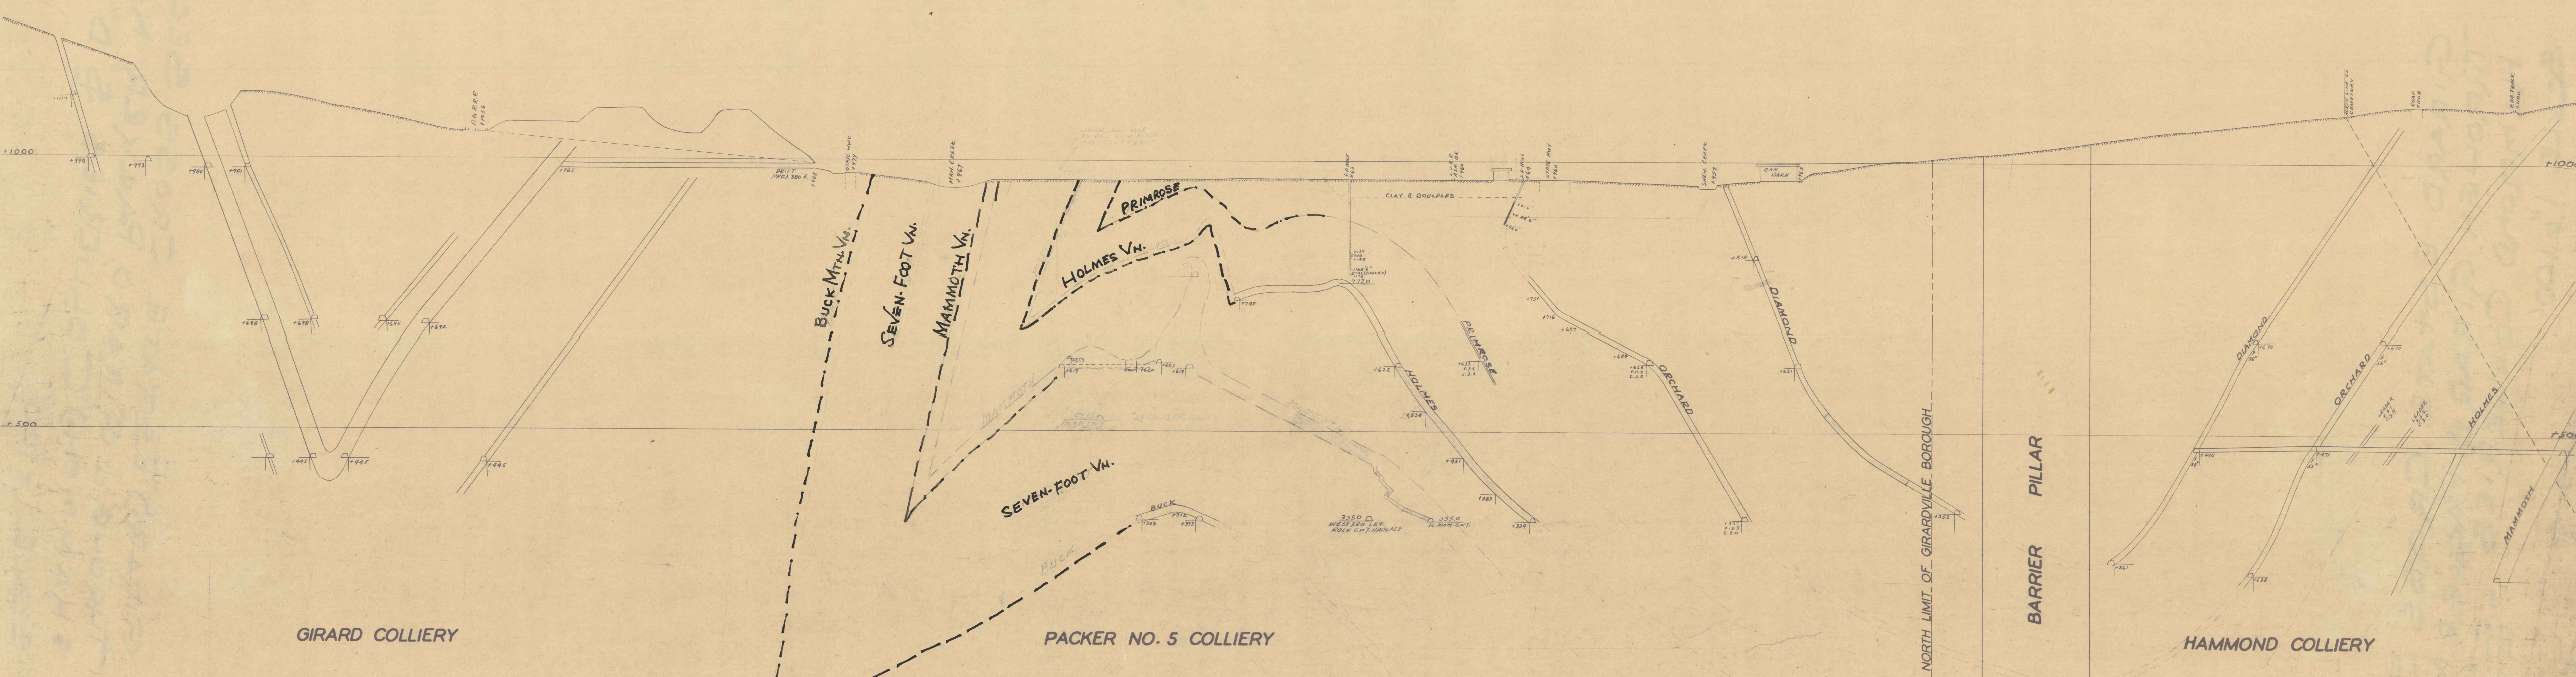

GIRARD COLLIERY

PACKER NO. 5 COLLIERY

HAMMOND COLLIERY

BUTLER TWP, SCHUYLKILL
COUNTY, PA., 11 W. Mahanoy Dist.,
LEHIGH VALLEY COLLIERIES.

WESTERN MIDDLE FIELD...
SECTION-LINE-D- (LOOKING WEST)
680-FT.-WEST-OF-NO: 1-SECTIONAL-TUNNEL-WEST,
3RD-LEVEL-2400-FT.-WEST-OF-SHAFT. ??
SCALE: 1" = 100.

MF
MAR 10 1972