


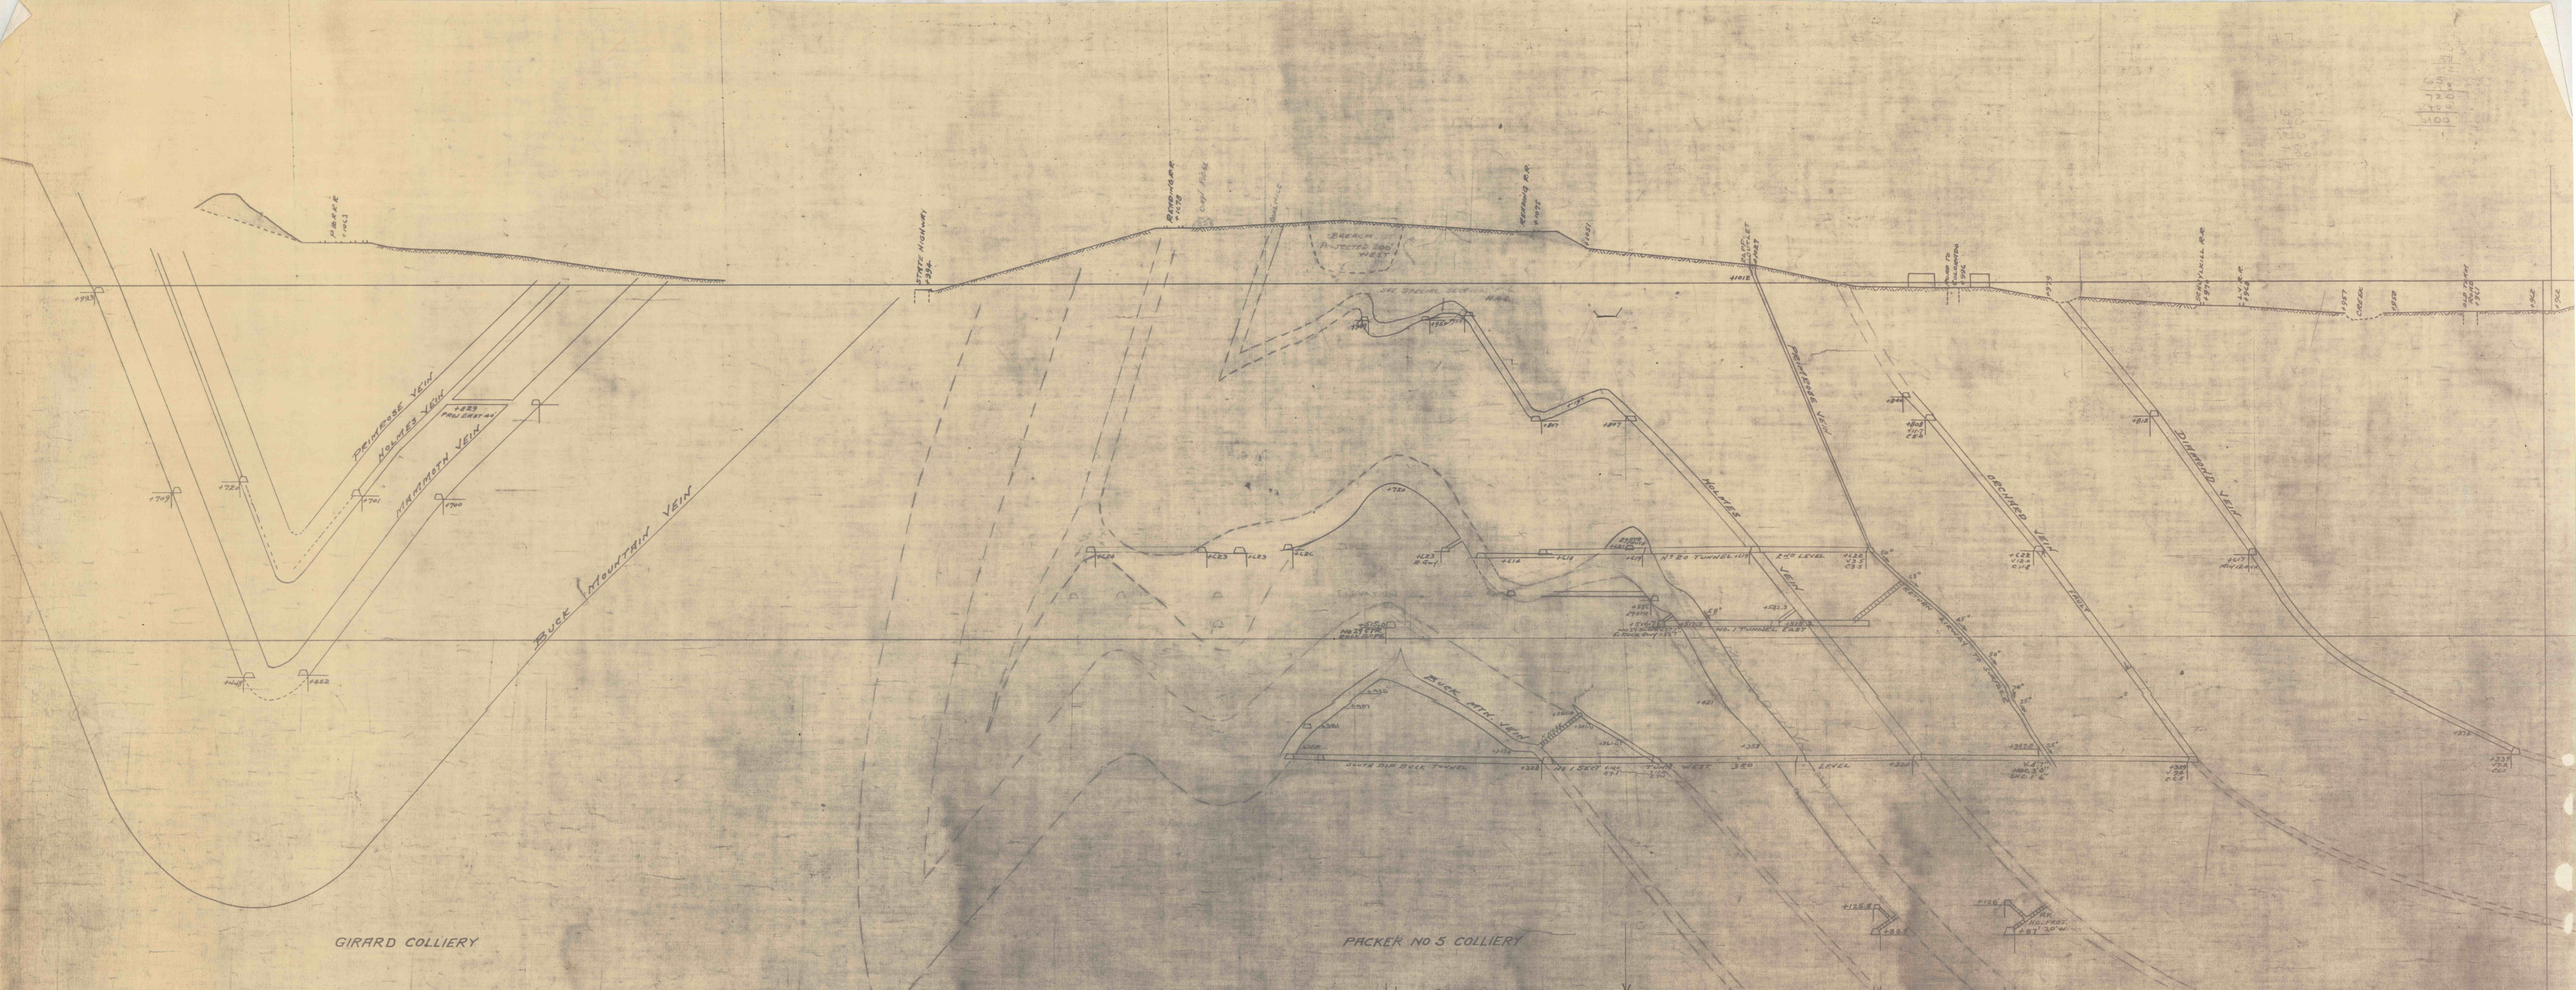

WESTERN MIDDLE FIELD.. BUTLER TWP., SCHUYLKILL CO., PA.,
 PACKER COLLIERY.. 11 W. MAHANOEY DIST., LEHIGH VALLEY
 NO: 5. . SECTION-LINE — E — (LOOKING WEST) — COLL'RS.

THROUGH-NO 20-TUNNEL-2ND LEVEL-AND-NO: 1-SECTIONAL-TUNNEL-WEST

3RD LEVEL — 1960 FEET — WEST-OF-SHAFT. ."

SCALE: 1" = 100'.

MF
 MAR 10 1972