


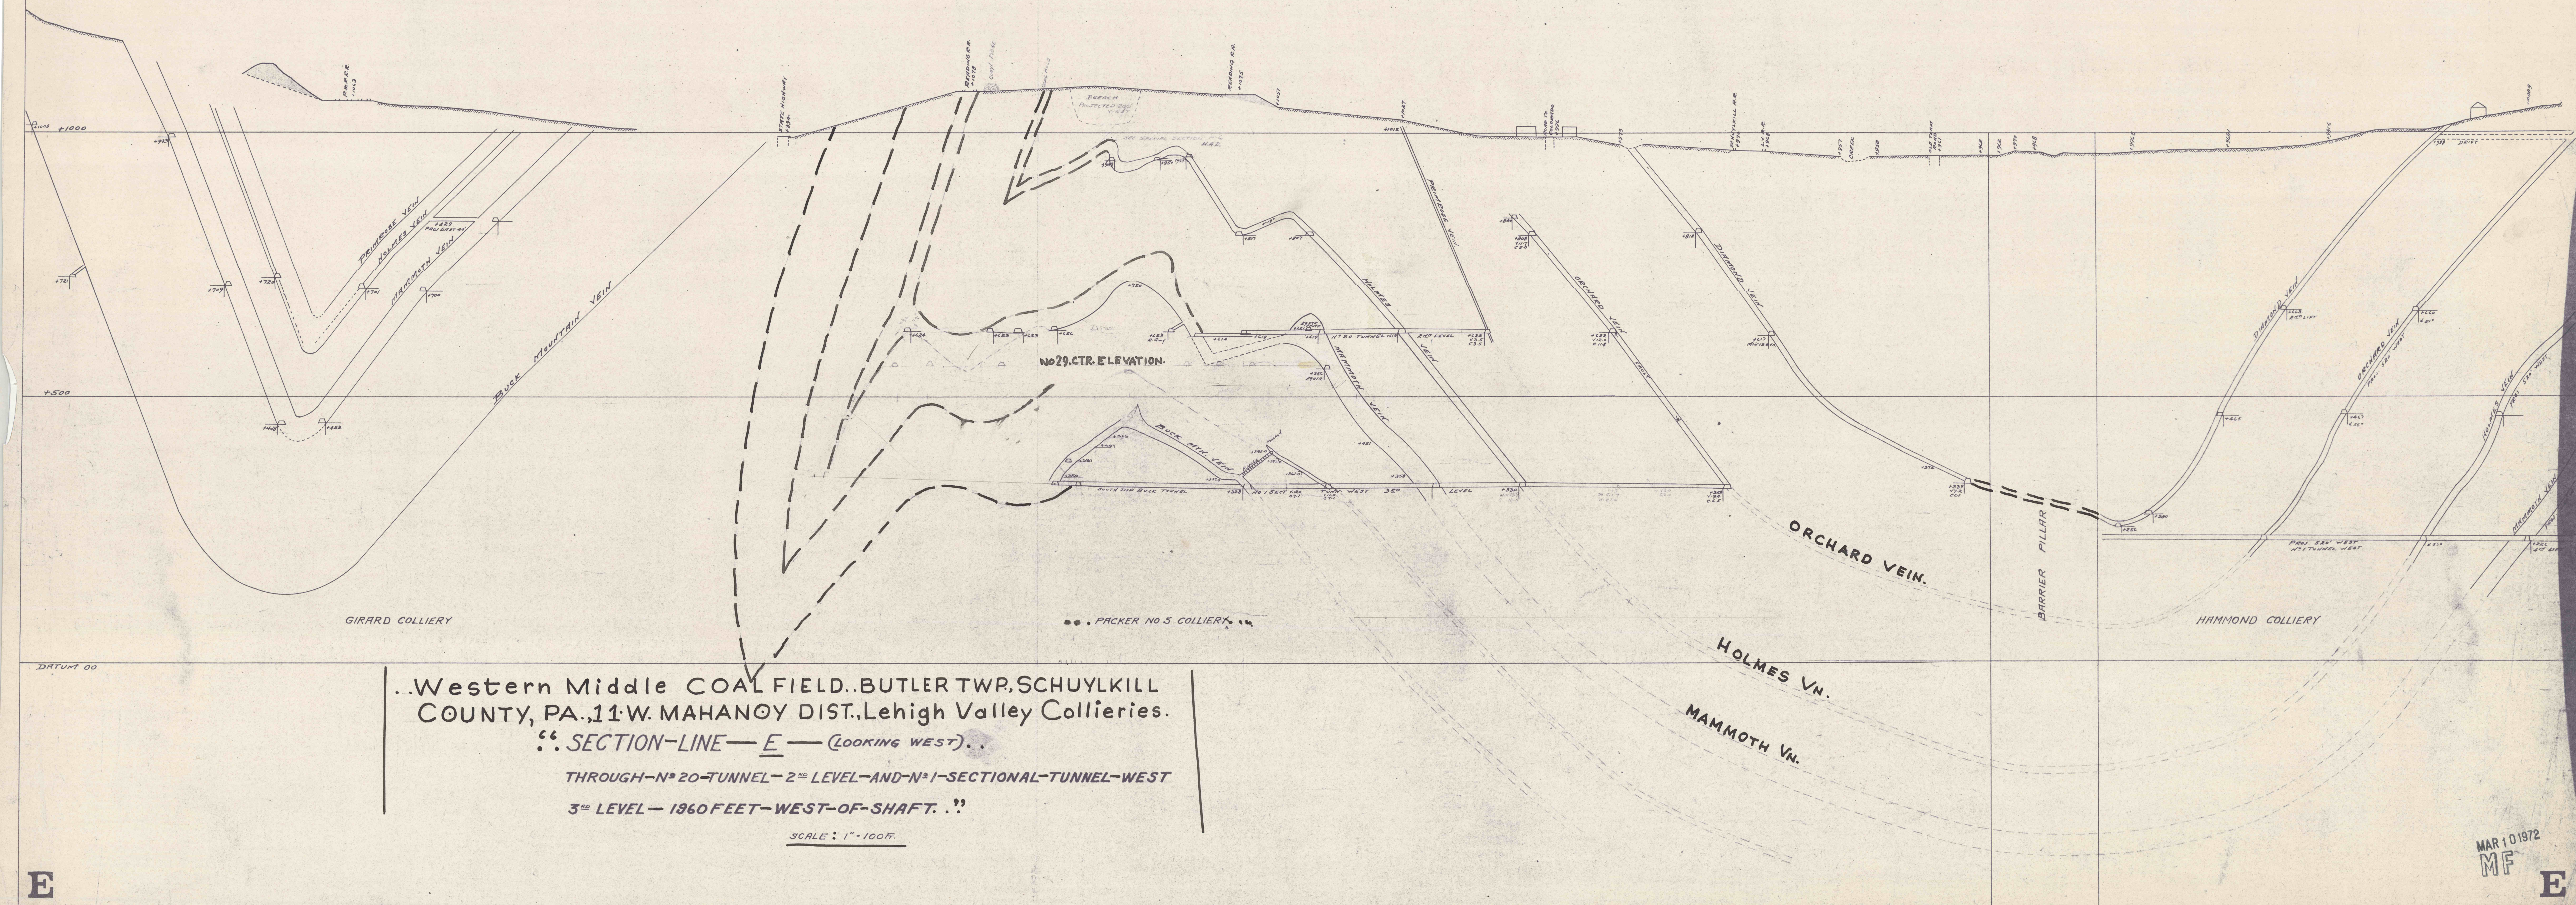

Western Middle COAL FIELD. BUTLER TWP., SCHUYLKILL COUNTY, PA., 11 W. MAHANÓY DIST., Lehigh Valley Collieries.

SECTION-LINE—E—(LOOKING WEST)..

THROUGH—N° 20—TUNNEL—2ND LEVEL—AND—N° 1—SECTIONAL—TUNNEL—WEST
3RD LEVEL—1960 FEET—WEST—OF—SHAFT. . .

SCALE : 1" = 100 FT.

MAR 10 1972
MF
E