


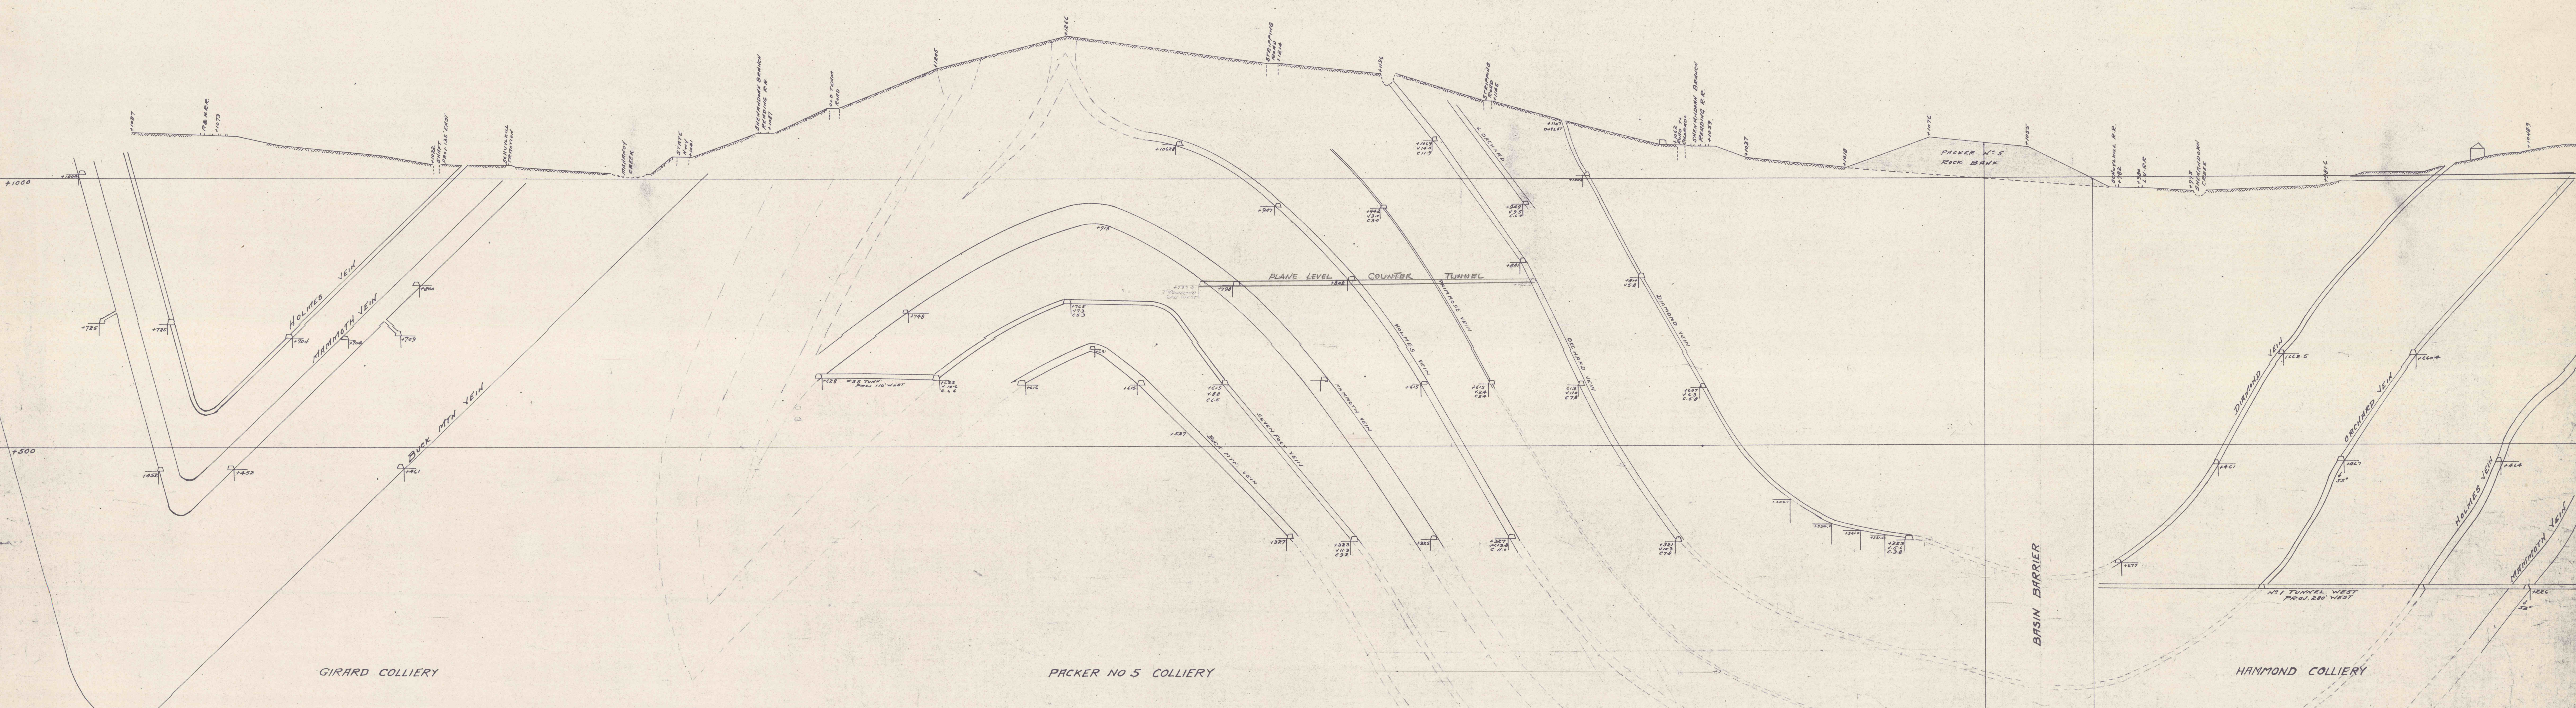

Western Middle Field..PACKER NO:5..COLLIERY..
BUTLER TWP, SCHUYLKILL COUNTY, PA..11 W. MAHANOEY
DISTRICT..LEHIGH VALLEY COLLIERIES..
"SECTION-LINE:-F-..(LOOKING WEST).."
BETWEEN-MAIN-TUNNEL-&-Nº:1-SECTIONAL-TUNNEL-WEST
3RD LEVEL:-860-Feet-WEST-OF-SHAFT..
SCALE:-1"=100F.

MF
MAR 10 1972
F