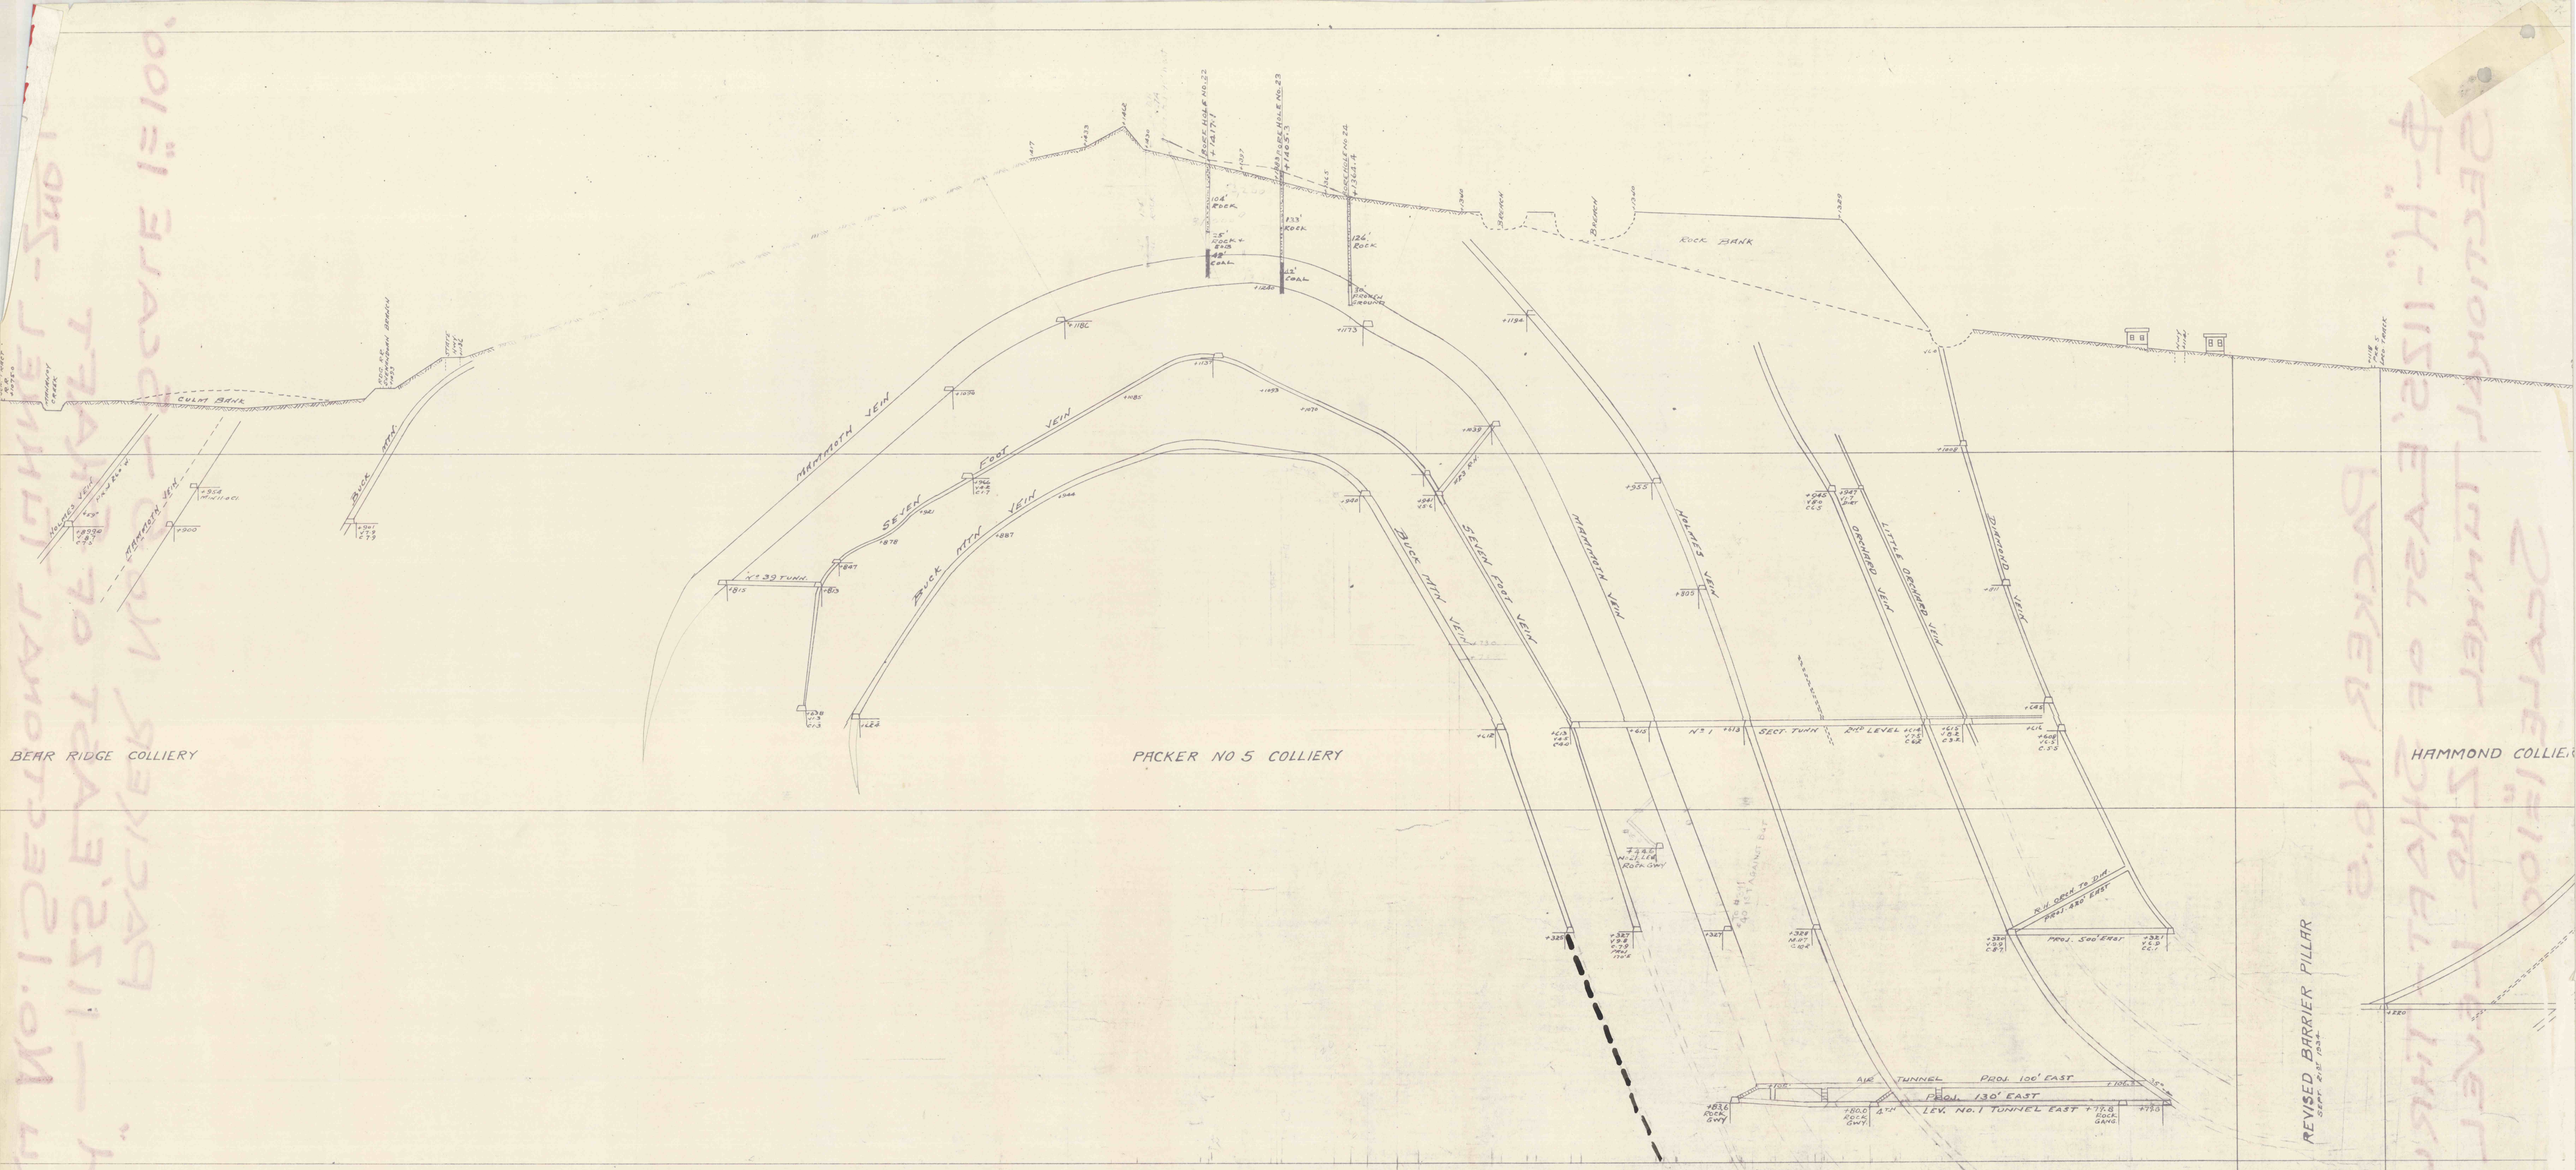

..WESTERN MIDDLE FIELD..

∴SECTION-LINE-H- (LOOKING WEST)..PACKER NO: 5·COLLIERY..

THROUGH-No 1-SECTIONAL-TUNNEL,-No 2-LEVEL-
1125-FEET-EAST-OF-SHAFT."

SCALE: 1" = 100 FT.

BUTLER TWP., SCHUYLKILL Co., PA.,

11·W. MAHANOY DISTRICT..LEHIGH VALLEY COLLIERIES.