


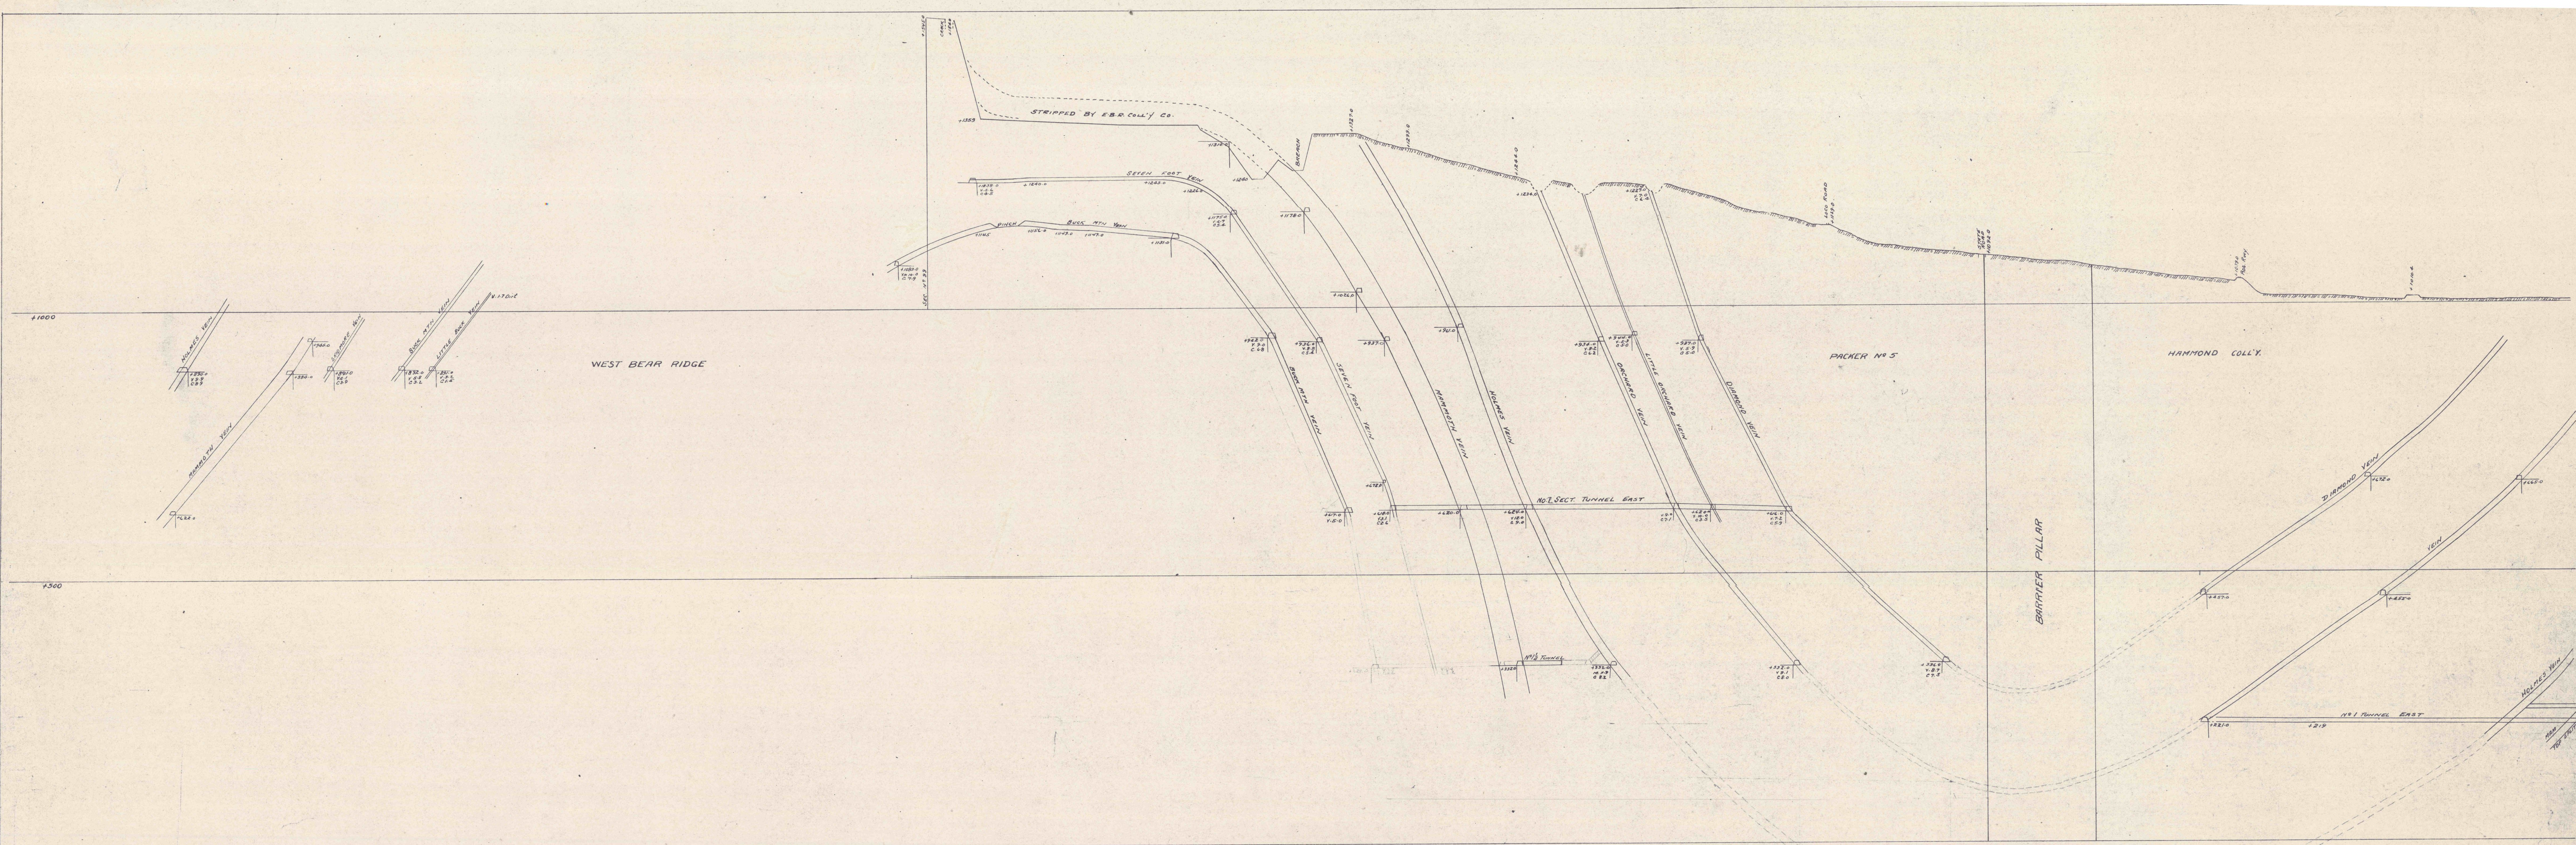

Western Middle Field...PACKER NO:5 COLLIERY..BUTLER TWP.  
SECTION-LINE-L... (LOOKING WEST)  
THROUGH NO:2 SECTIONAL-TUNNEL-NO:2-LEVEL  
& NO:1 1/2 SECTIONAL-TUNNEL-NO:3-LEVEL  
2635 FEET-EAST-OF-SHAFT."  
SCALE:1"=100 FT.

SCHUYLKILL COUNTY, PA..11 W. MAHANOHY DISTRICT.  
LEHIGH VALLEY COLLIERIES.

L

MAR 10 1972 MF L