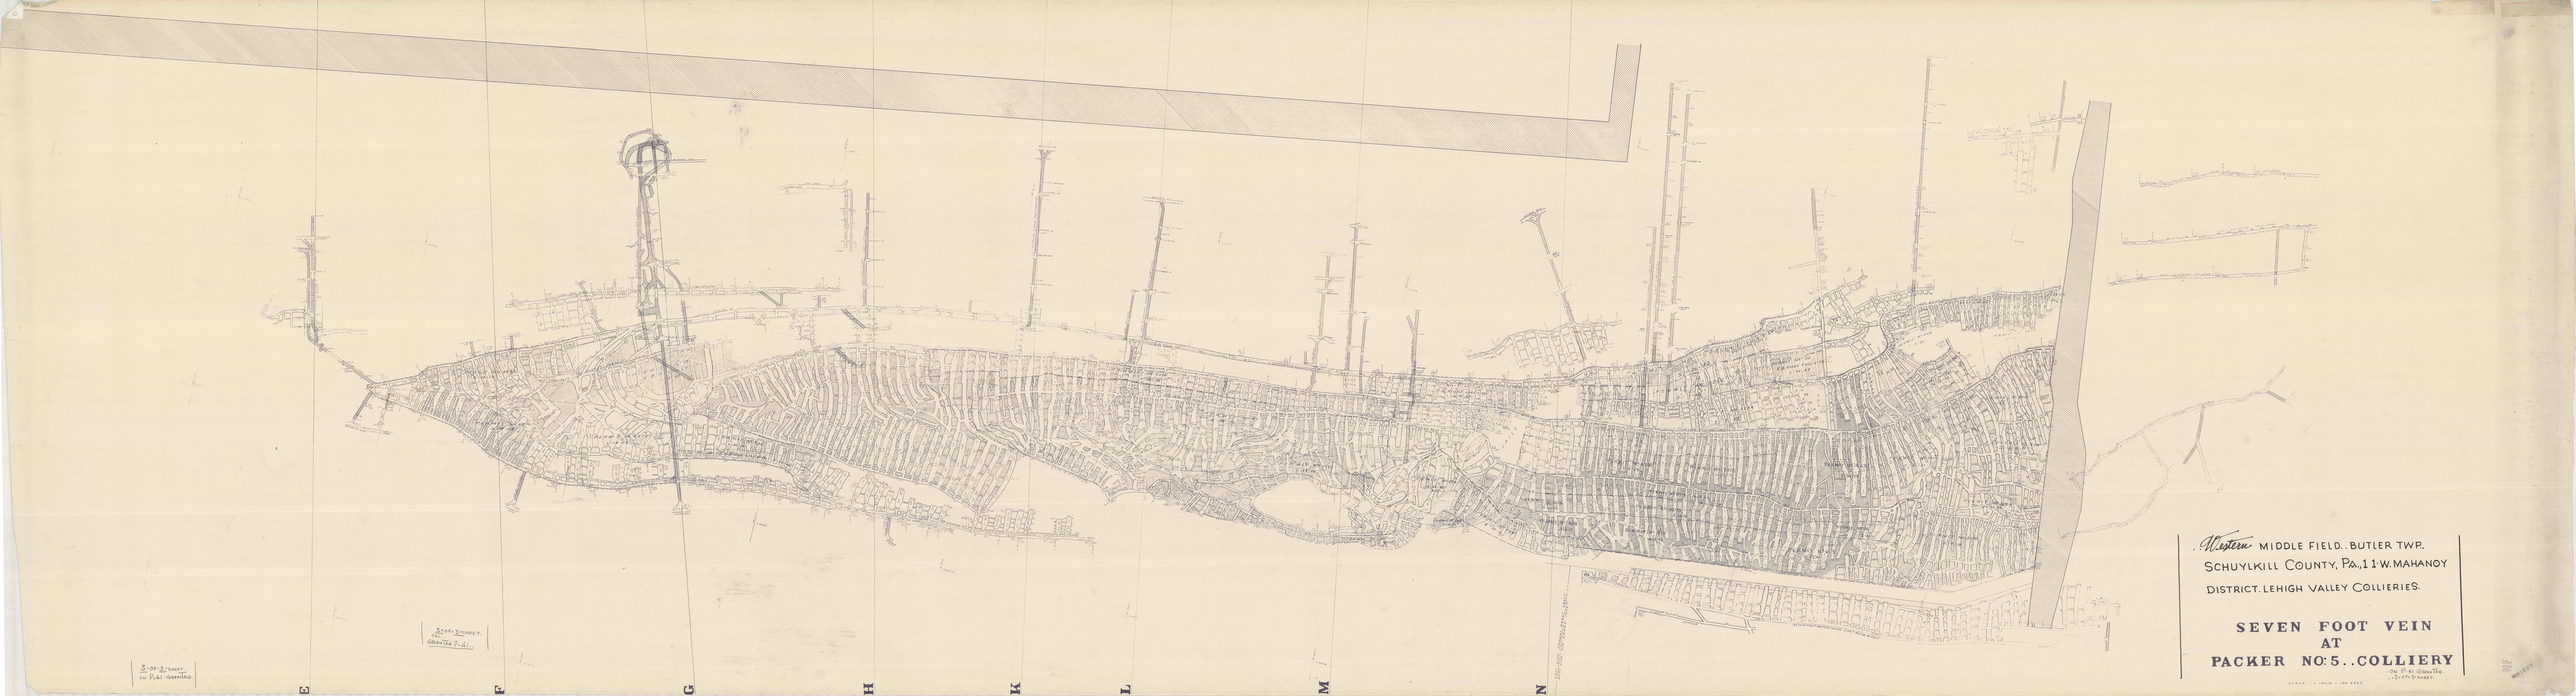
Western MIDDLE FIELD. BUTLER TWP.
SCHUYLKILL COUNTY, PA., 1 1/2 W. MAHANOY
DISTRICT. LEHIGH VALLEY COLLIERIES.
SEVEN FOOT VEIN
AT
PACKER NO: 5. . COLLIERY
E
F
G
H
K
L
M
N