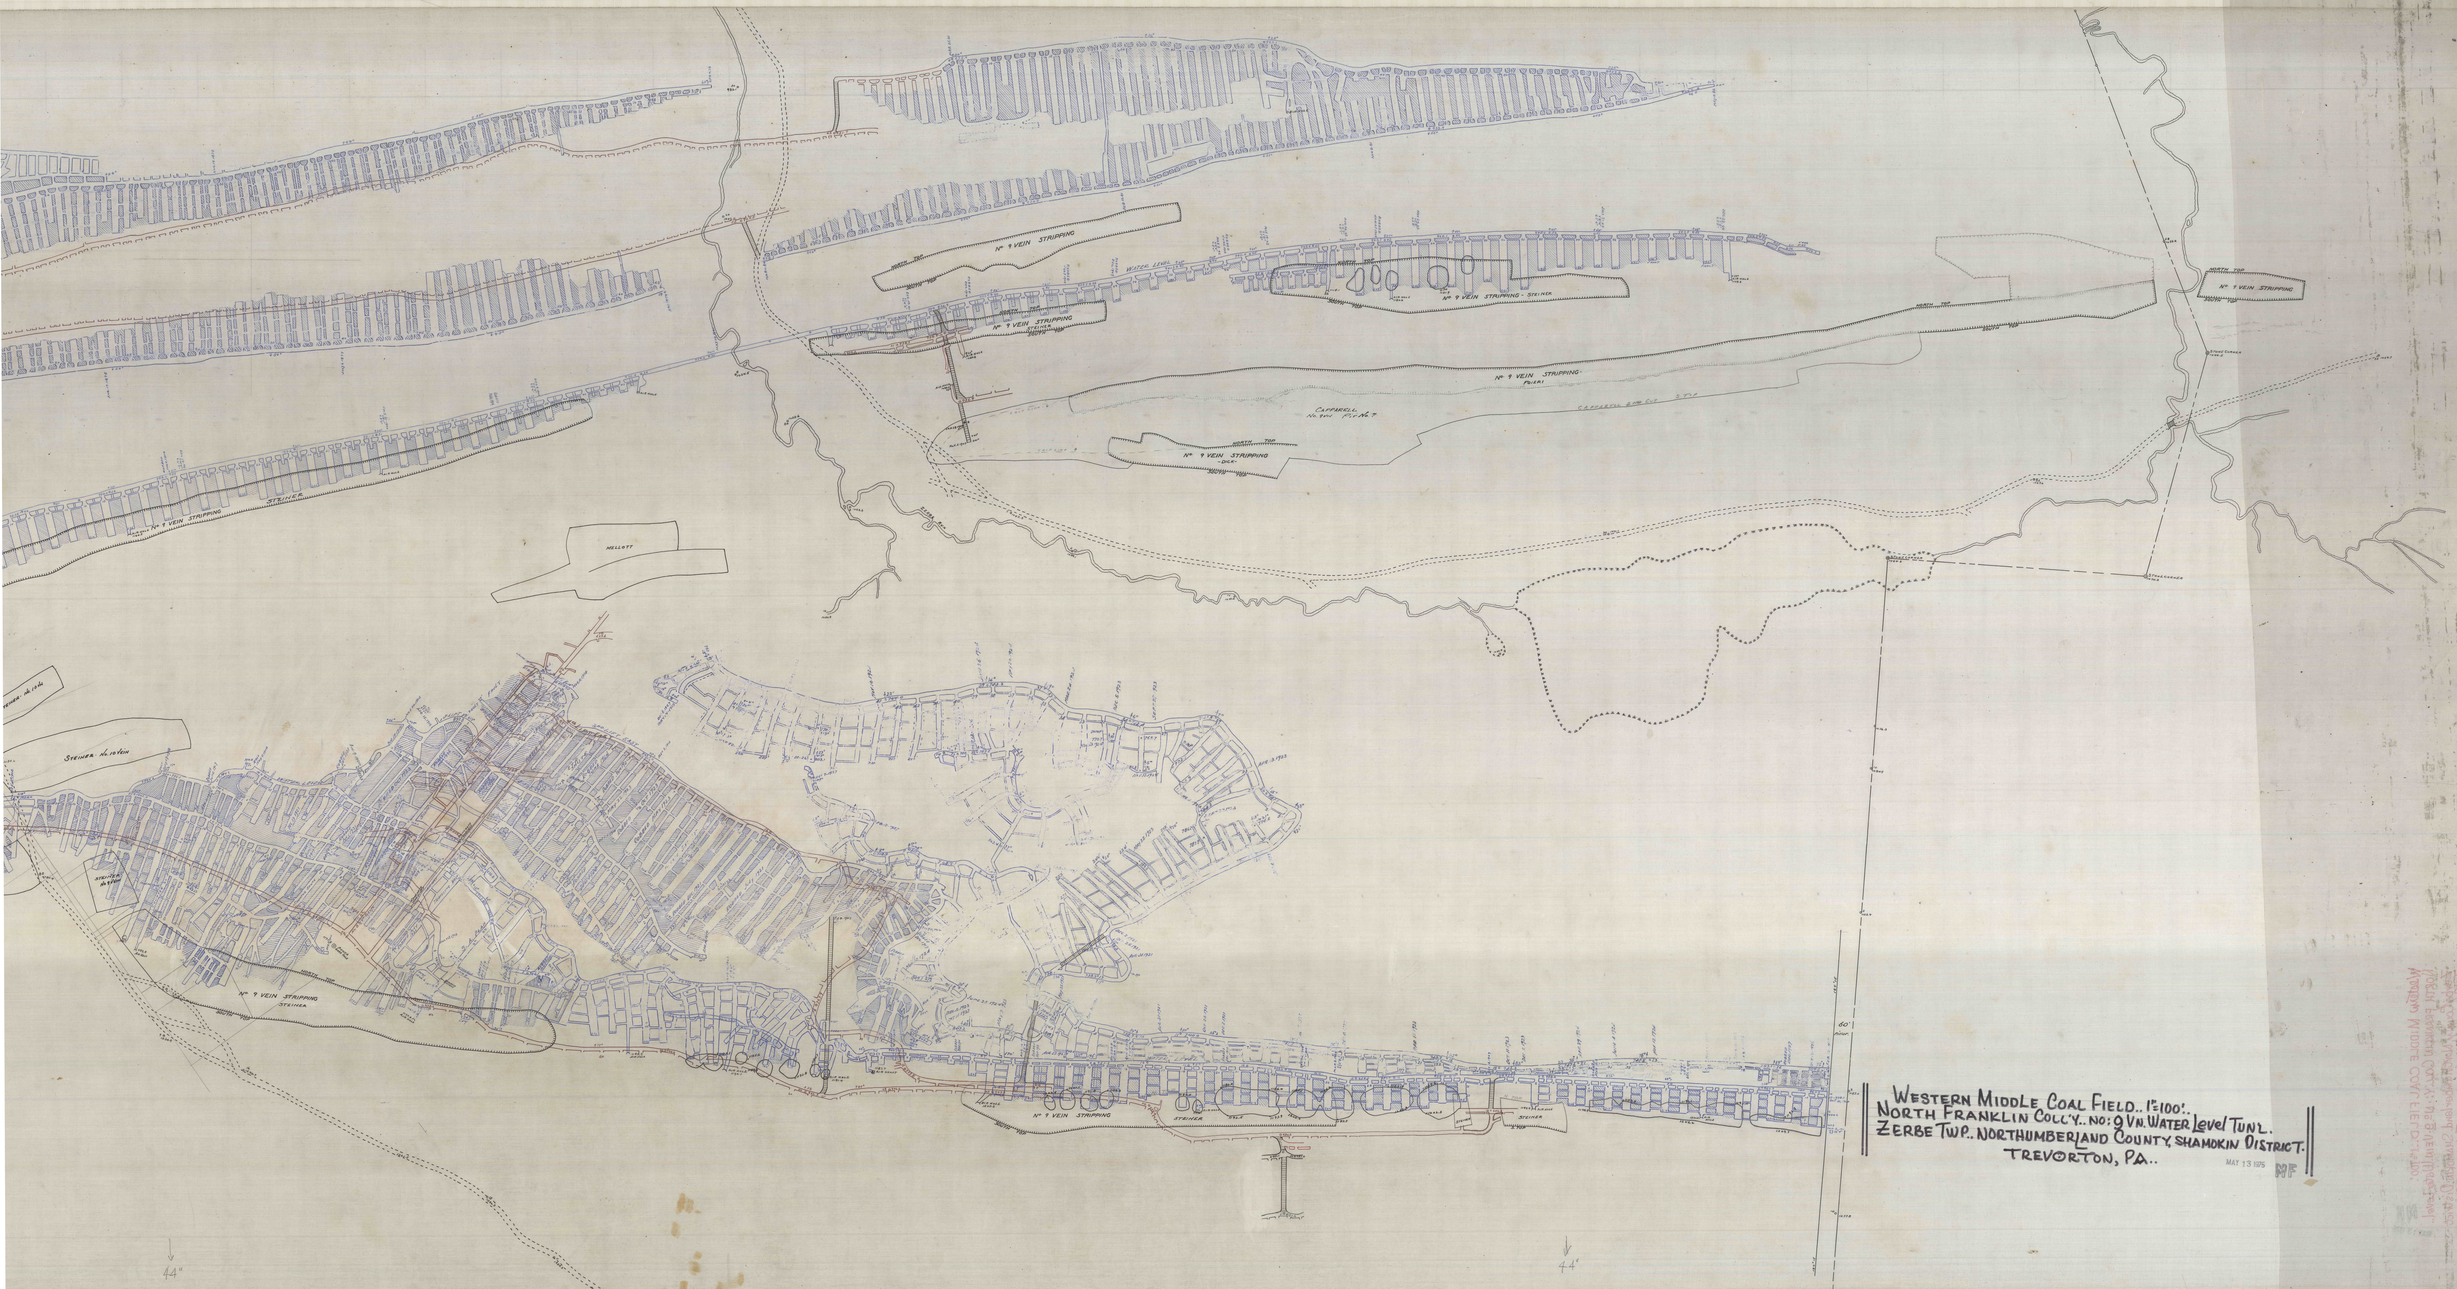

No 9 VEIN STRIPPING
NORTH TOP
SOUTH TOP
WATER LEVEL
TURNOUT
No 9 VEIN STRIPPING STEINER
No 9 VEIN STRIPPING - STEINER
No 9 VEIN STRIPPING FOIERI
CAPPARELL No. 9 VN PIT No. 7
CROP LINE
No 9 VEIN STRIPPING -DICK-
AIR HOLE
ROBBED
ZERBE RUN
MELLOTT
STEINER - No. 10 VN
STEINER - No. 10 VEIN
STEINER No 9 VEIN
WATER LEVEL
2ND. LIFT EAST
1ST. LIFT W.
FAULT
SLOPE
COUNTER SHUTE
TRAVELING WAY
CONCRETE OVERCAST
S. A. PLAN
POWER BORE HOLE
No 9 VEIN STRIPPING STEINER
No 9 VEIN STRIPPING
STEINER
60'
Pillar.
44"
44"

WESTERN MIDDLE COAL FIELD.. 1"=100'..
NORTH FRANKLIN COLL'Y.. NO: 9 VN. WATER Level TUNL.
ZERBE TWP.. NORTHUMBERLAND COUNTY, SHAMOKIN DISTRICT.
TREVORTON, PA..

MAY 13 1975

MF