TURNOUT
FAULTY
FAULT
FAULTY

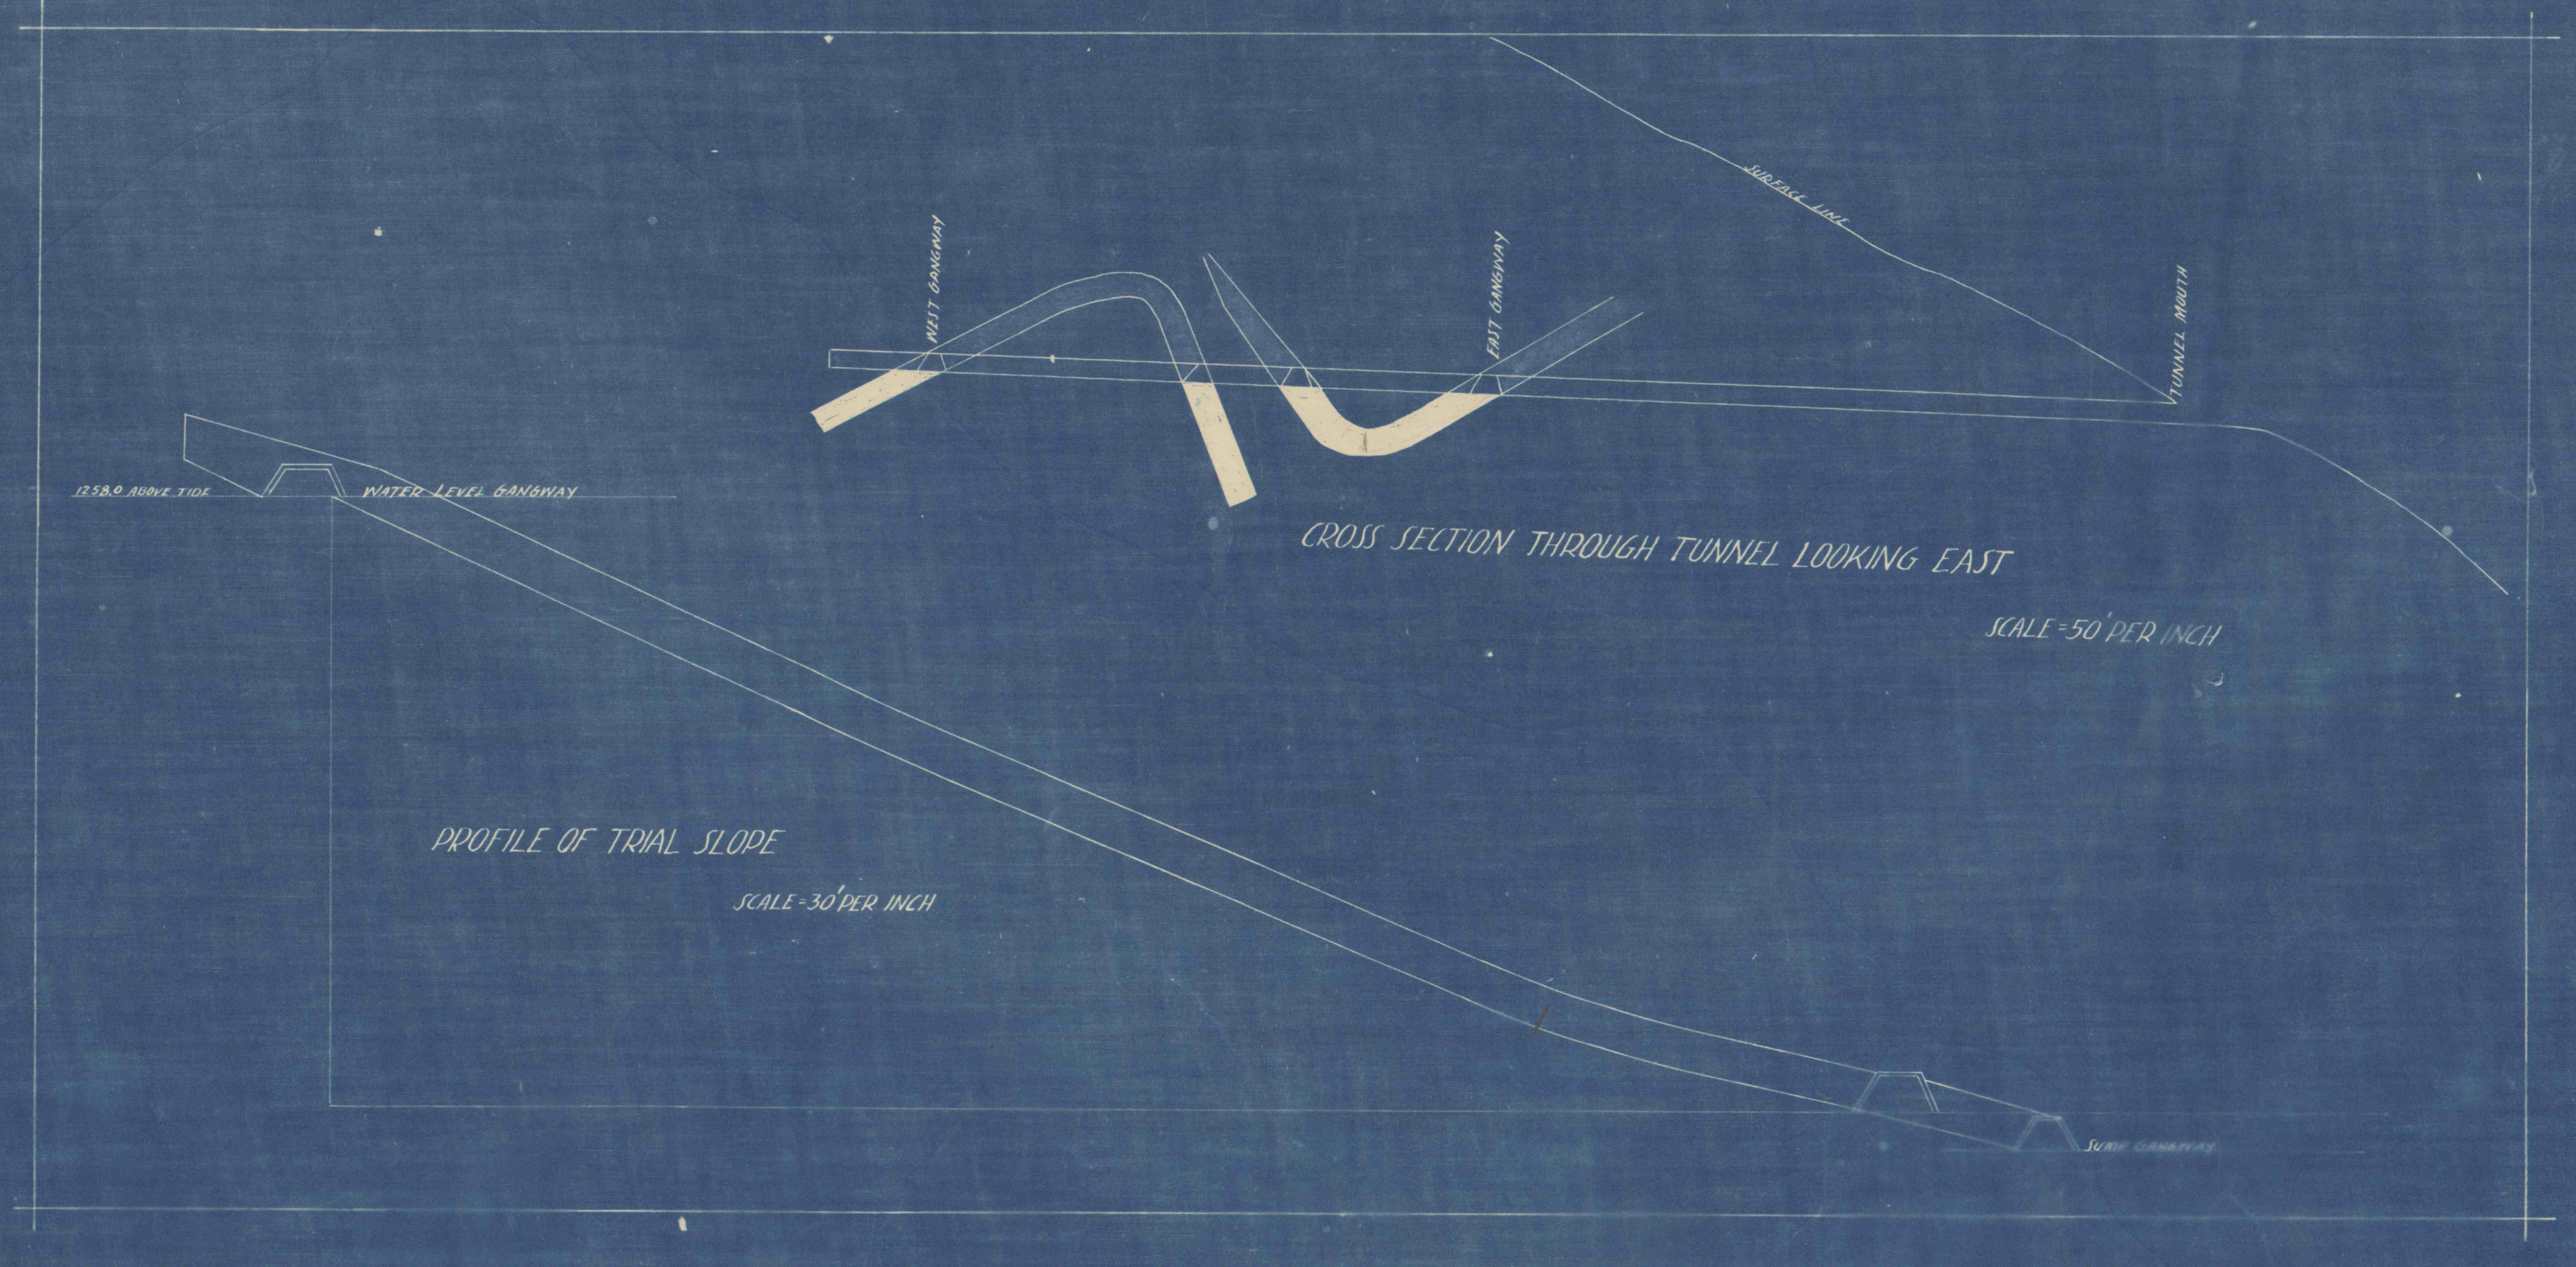
WEST GANGWAY
EAST GANGWAY
SURFACE LINE
TUNNEL MOUTH
1258.0 ABOVE TIDE
WATER LEVEL GANGWAY
SUMP GANGWAY

CROSS SECTION THROUGH TUNNEL LOOKING EAST

SCALE = 50' PER INCH

PROFILE OF TRIAL SLOPE

SCALE = 30' PER INCH

SECTIONS OF VEIN

		FT	IN	FT	IN
A	TOP				
	BONEY	2	10		
	SLATE		11		
	COAL GOOD	7	0		
	SOFT DIRT		9		
	BOTTOM			11	6
B	TOP				
	COAL	1	6		
	BONE & SLATE	1	0		
	COAL	5	0		
	DIRT	1	0		
	BOTTOM			8	6
C	TOP				
	SOFT DIRT	0	4		
	BOTTOM			0	4
D	TOP				
	BONEY & SLATE	2	0		
	SOFT COAL	7	4		
	DIRT	2	6		
	BOTTOM			11	10
E	TOP				
	BONY COAL & DIRT	4	3		
	COAL GOOD	5	6		
	DIRT	1	3		
	BOTTOM			10	6
F	TOP				
	COAL	1	2		
	BONEY	2	5		
	COAL GOOD	6	0		
	DIRT	0	9		
	BOTTOM			10	4
G	TOP				
	SLATE & BONY	2	6		
	COAL GOOD	7	0		
	DIRT	1	3		
	BOTTOM			10	9

WESTERN MIDDLE COAL FIELD.
BUCK Mtn Vein, 1"=50'.
NORTH Franklin Colliery.
NORTHUMBERLand County, Pa.

MF
MAY 13 1975

MF
MAY 13 1975