

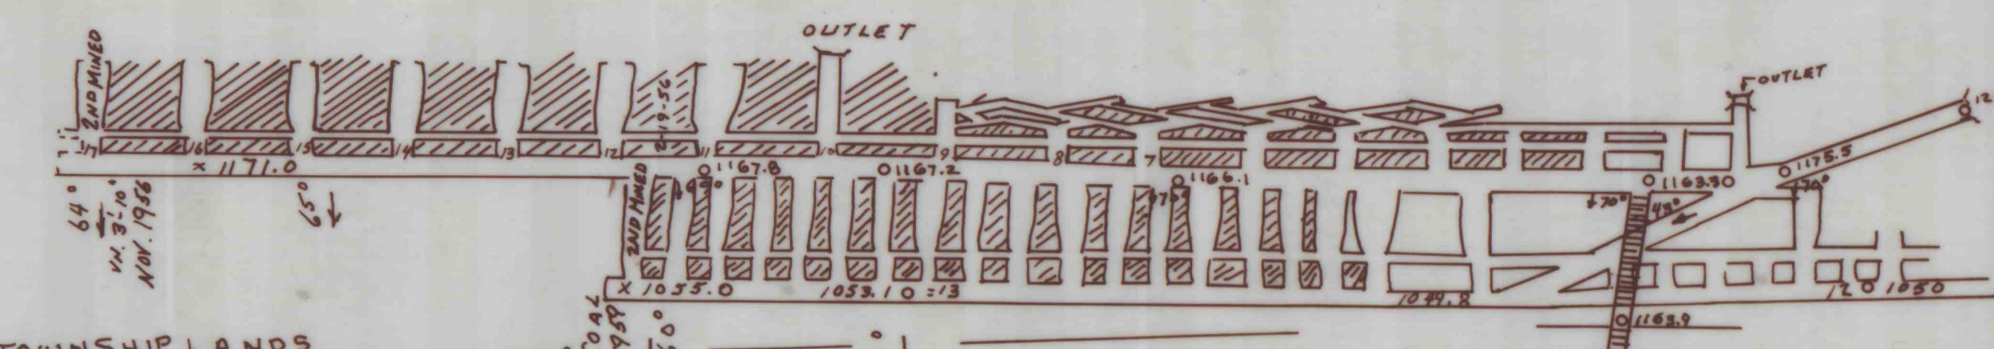
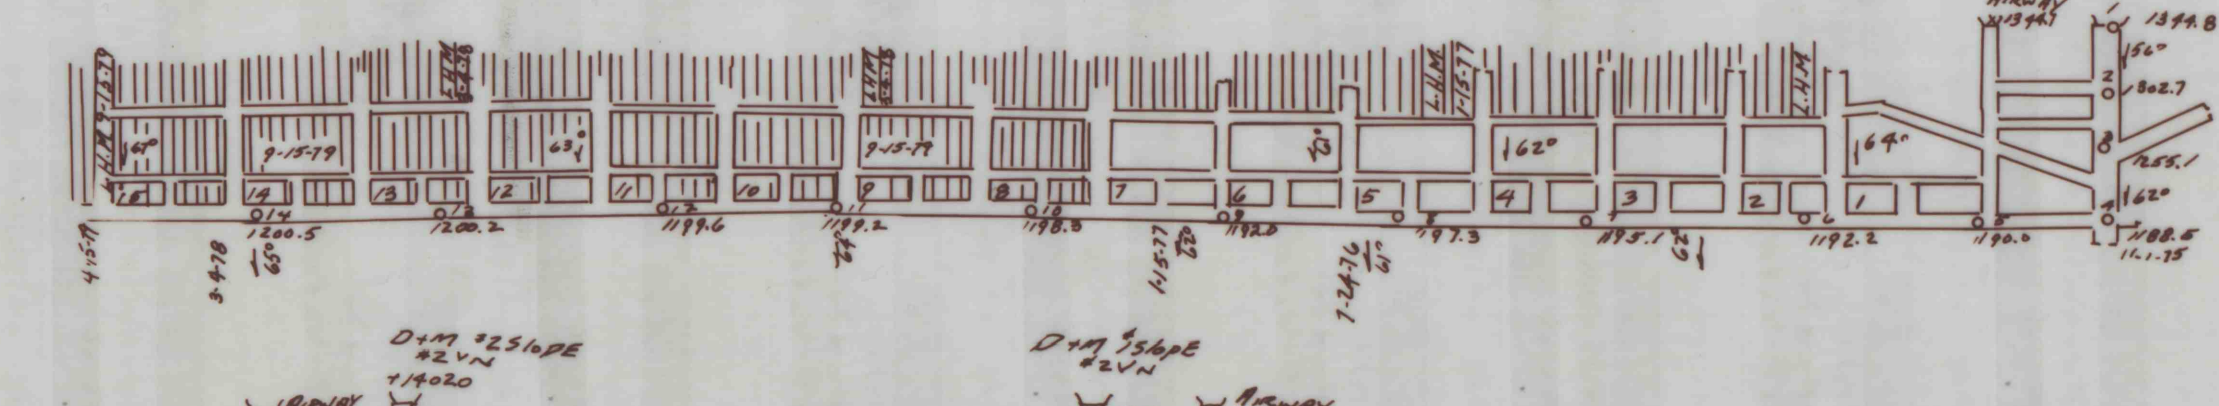


TRACED FROM
K & D COAL COMPANY
No. 2 VEIN
DATE: 11/1/82
BY: WARREN ASSOCIATES, INC.
STEVE BOYER, PLS.

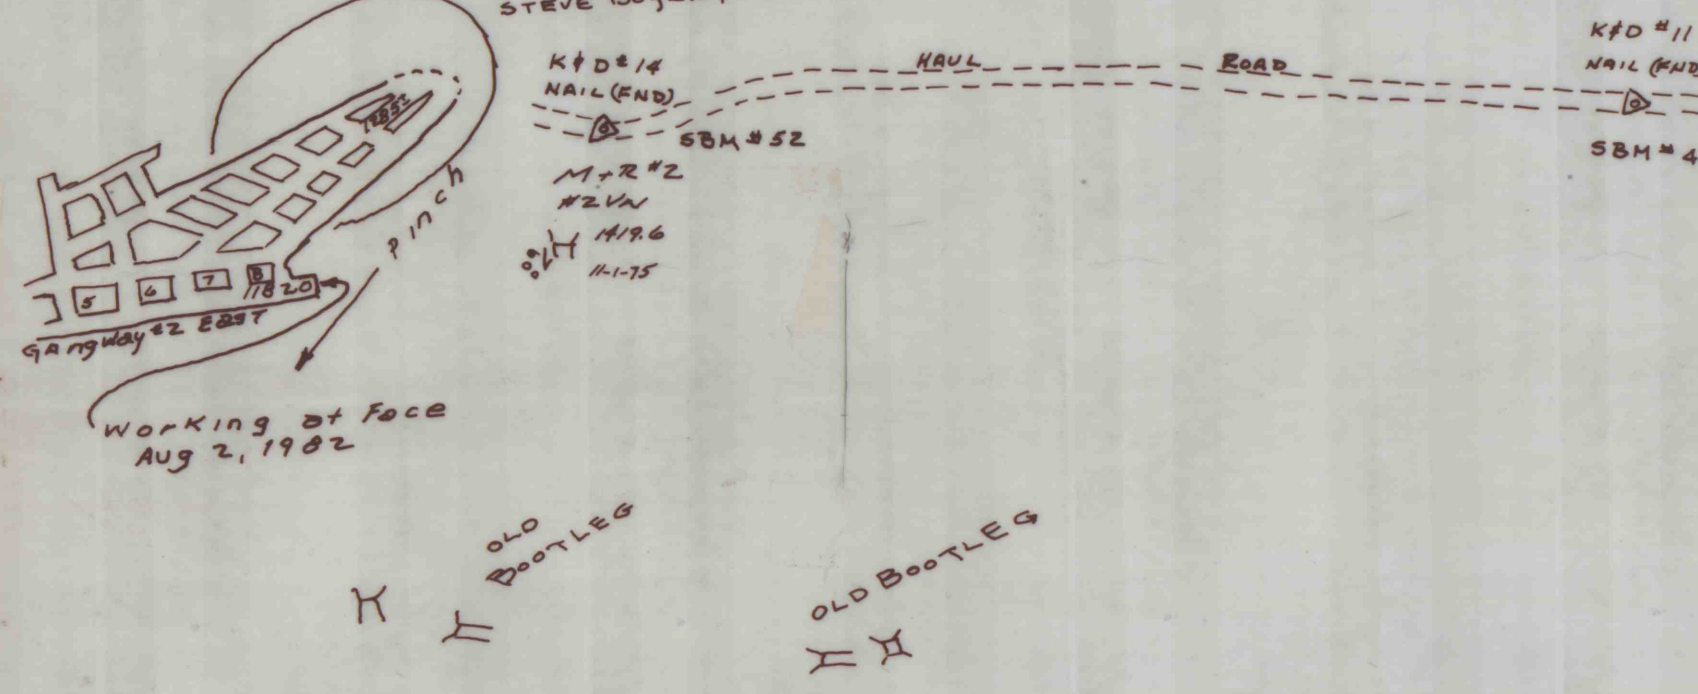

TRACED FROM PLANS
OF
NORTH FRANKLIN COLLIERY
VAINS #2, 3 & 5
K & D COAL COMPANY
AND
LADY LUCK COAL COMPANY
SCALE: 1" = 100'
PLAN #6 OF 6

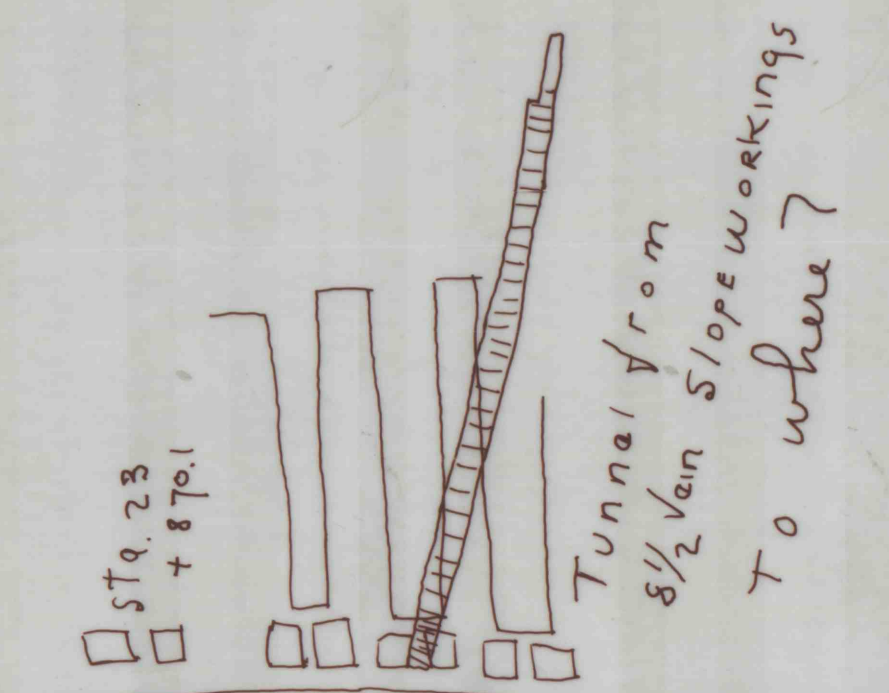

8 1/2
TREVORTON ESTATE
ASSOCIATE LANDS

200 + 100
(200 + 100)