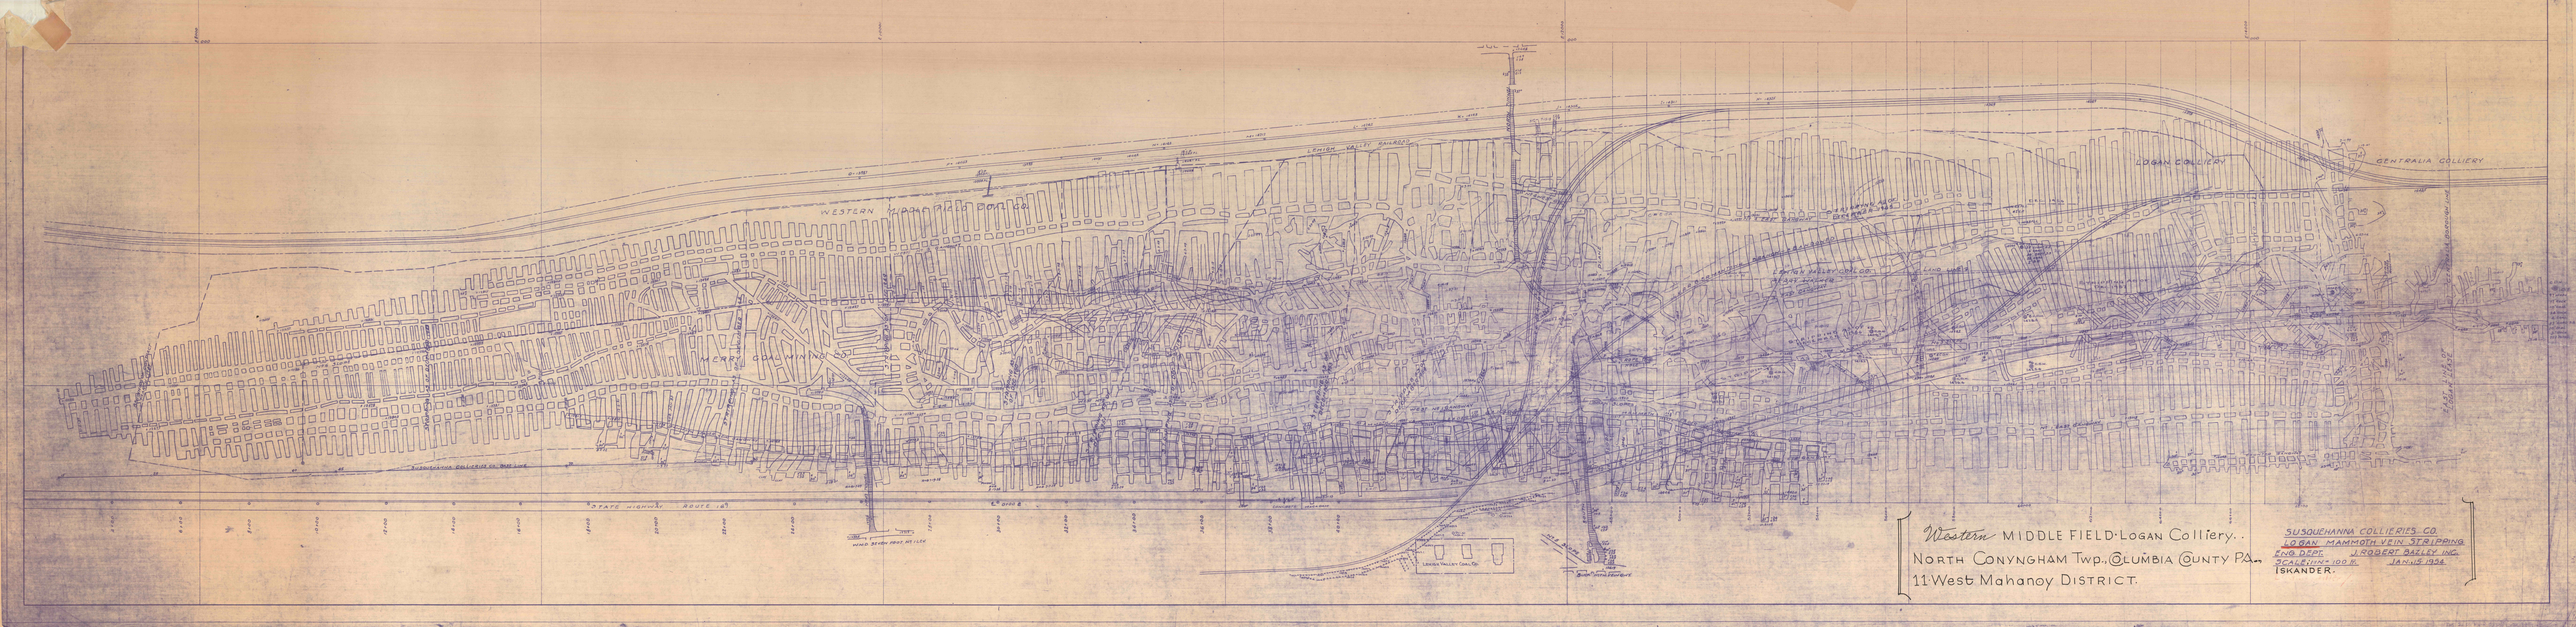
Western MIDDLE FIELD-Logan Colliery.
NORTH CONYNGHAM Twp., COLUMBIA COUNTY PA.
11 West Mahanoy DISTRICT.
SUSQUEHANNA COLLIERIES CO.
LOGAN MAMMOTH VEIN STRIPPING
ENG. DEPT. J. ROBERT BAILEY INC.
SCALE: 1" = 100 ft. JAN. 15 1934
ISKANDER.
WESTERN
LEHIGH VALLEY RAILROAD
LOGAN COLLIERY
CENTRALIA COLLIERY
MERRY COAL MINE CO.
STATE HIGHWAY ROUTE 183
SUSQUEHANNA COLLIERIES CO. PROP. LINE
LEHIGH VALLEY COAL CO.
EAST VALLEY