


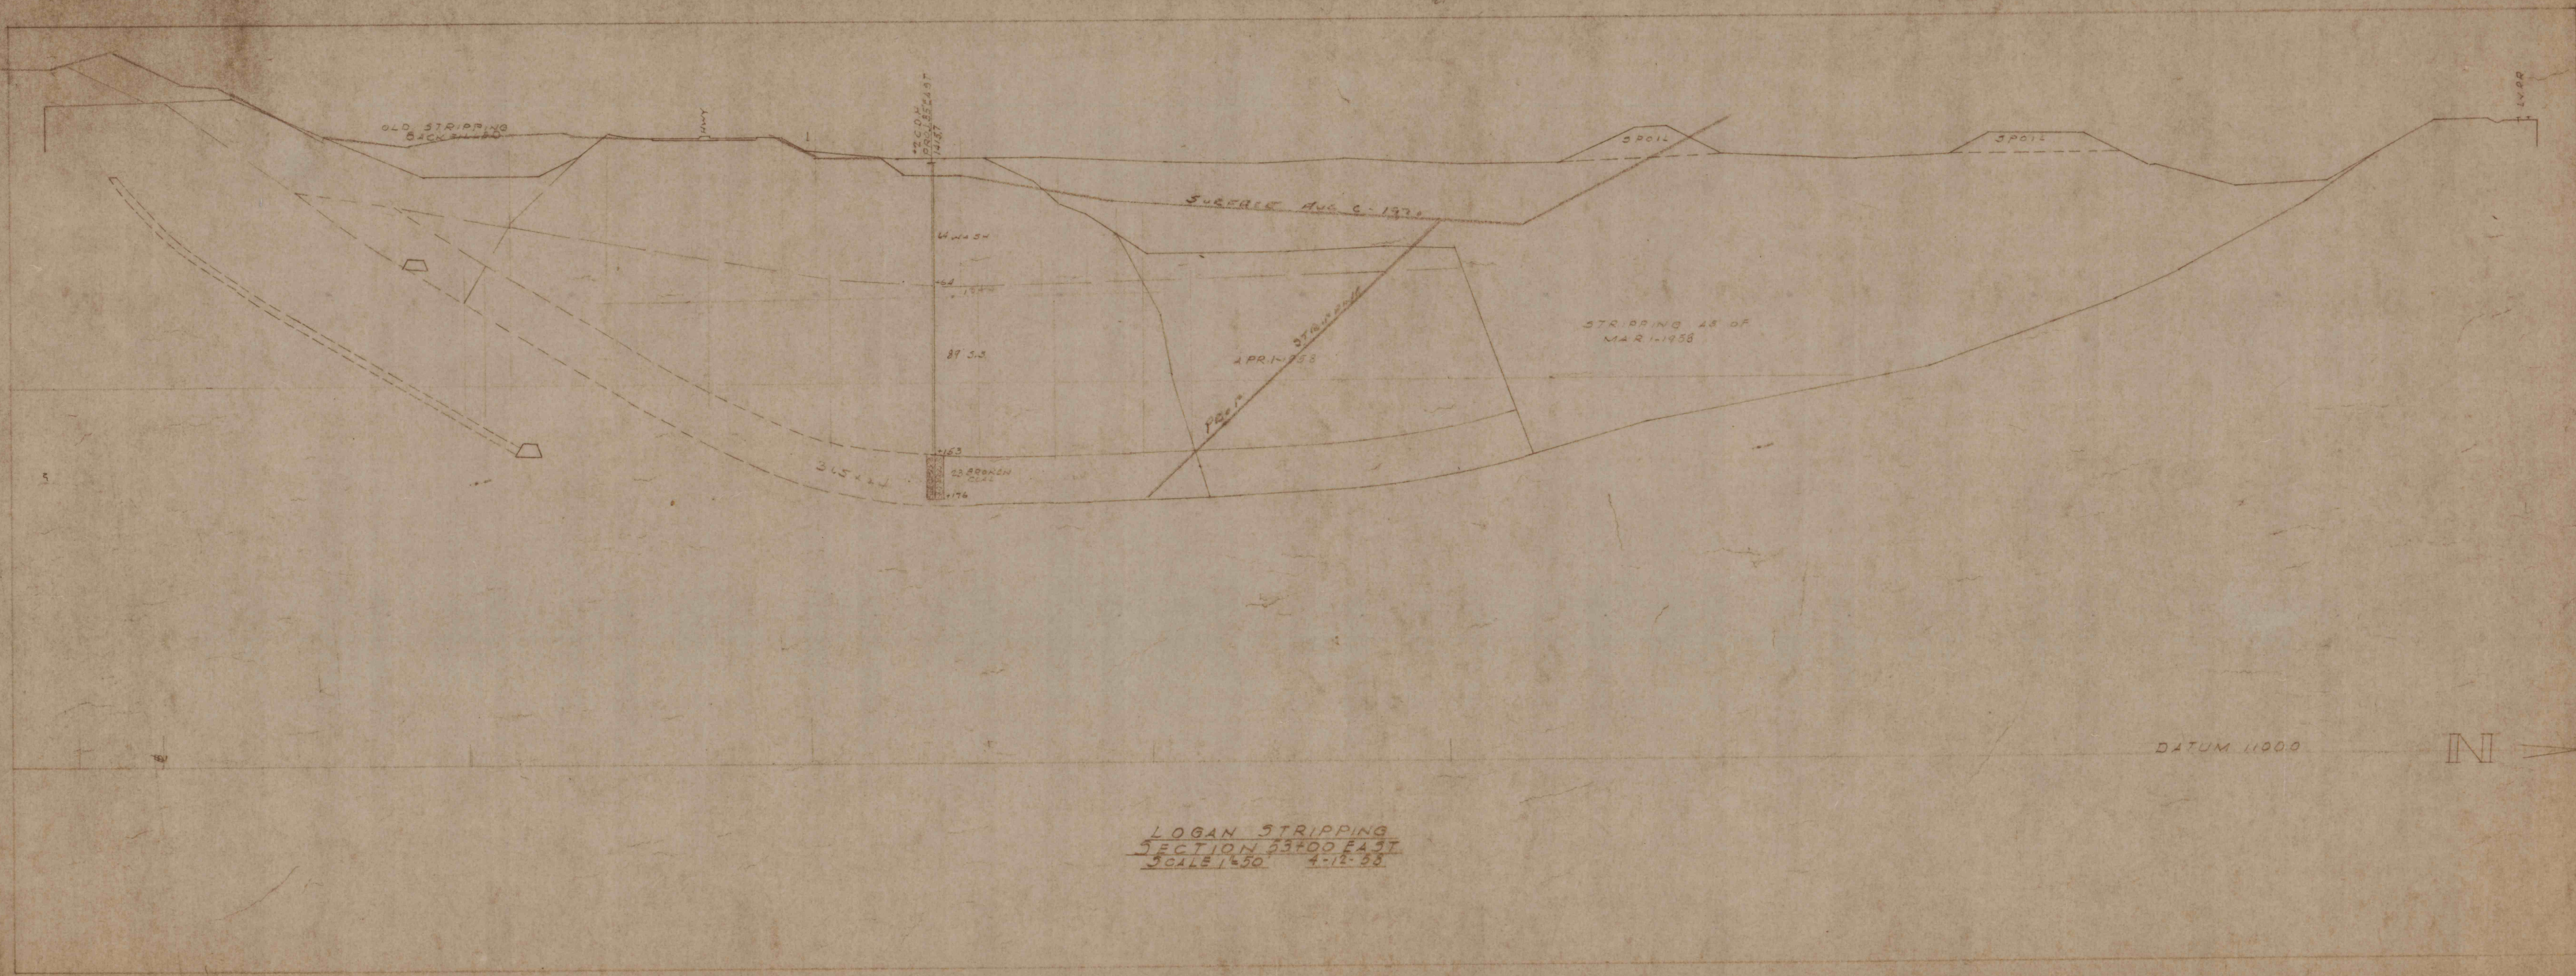

OLD STRIPPING
BACKFILL

2200
DRELLER
1487

WASH

87.5.3

1163

23 BOREN
COAL

SURFACE AUG 6-1970

APR 1-1958

STRIPPING

STRIPPING AS OF
MAR 1-1958

SPOIL

SPOIL

DATUM 11000

N

LOGAN STRIPPING
SECTION 53+00 EAST
SCALE 1/250 4-12-58