


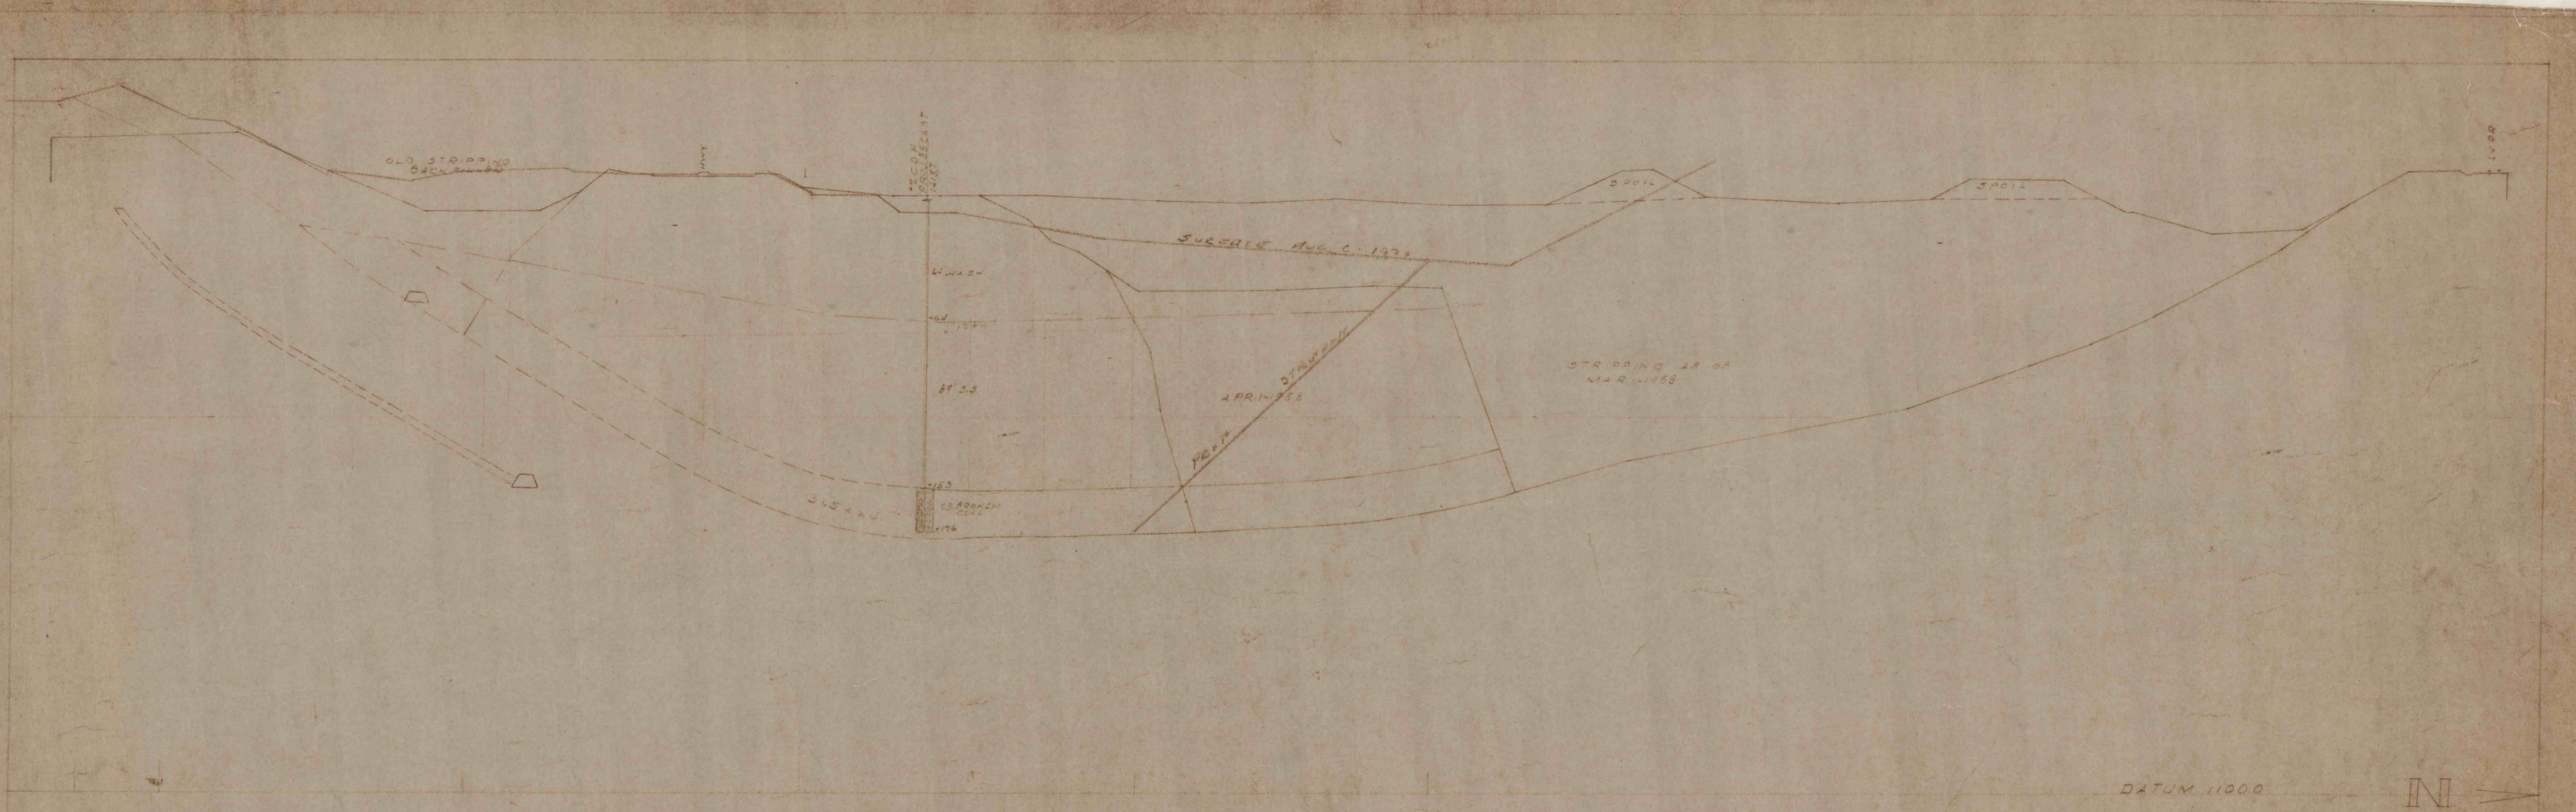

LOGAN STRIPPING
SECTION 53+00 EAST
SCALE 1/430 4-12-58