


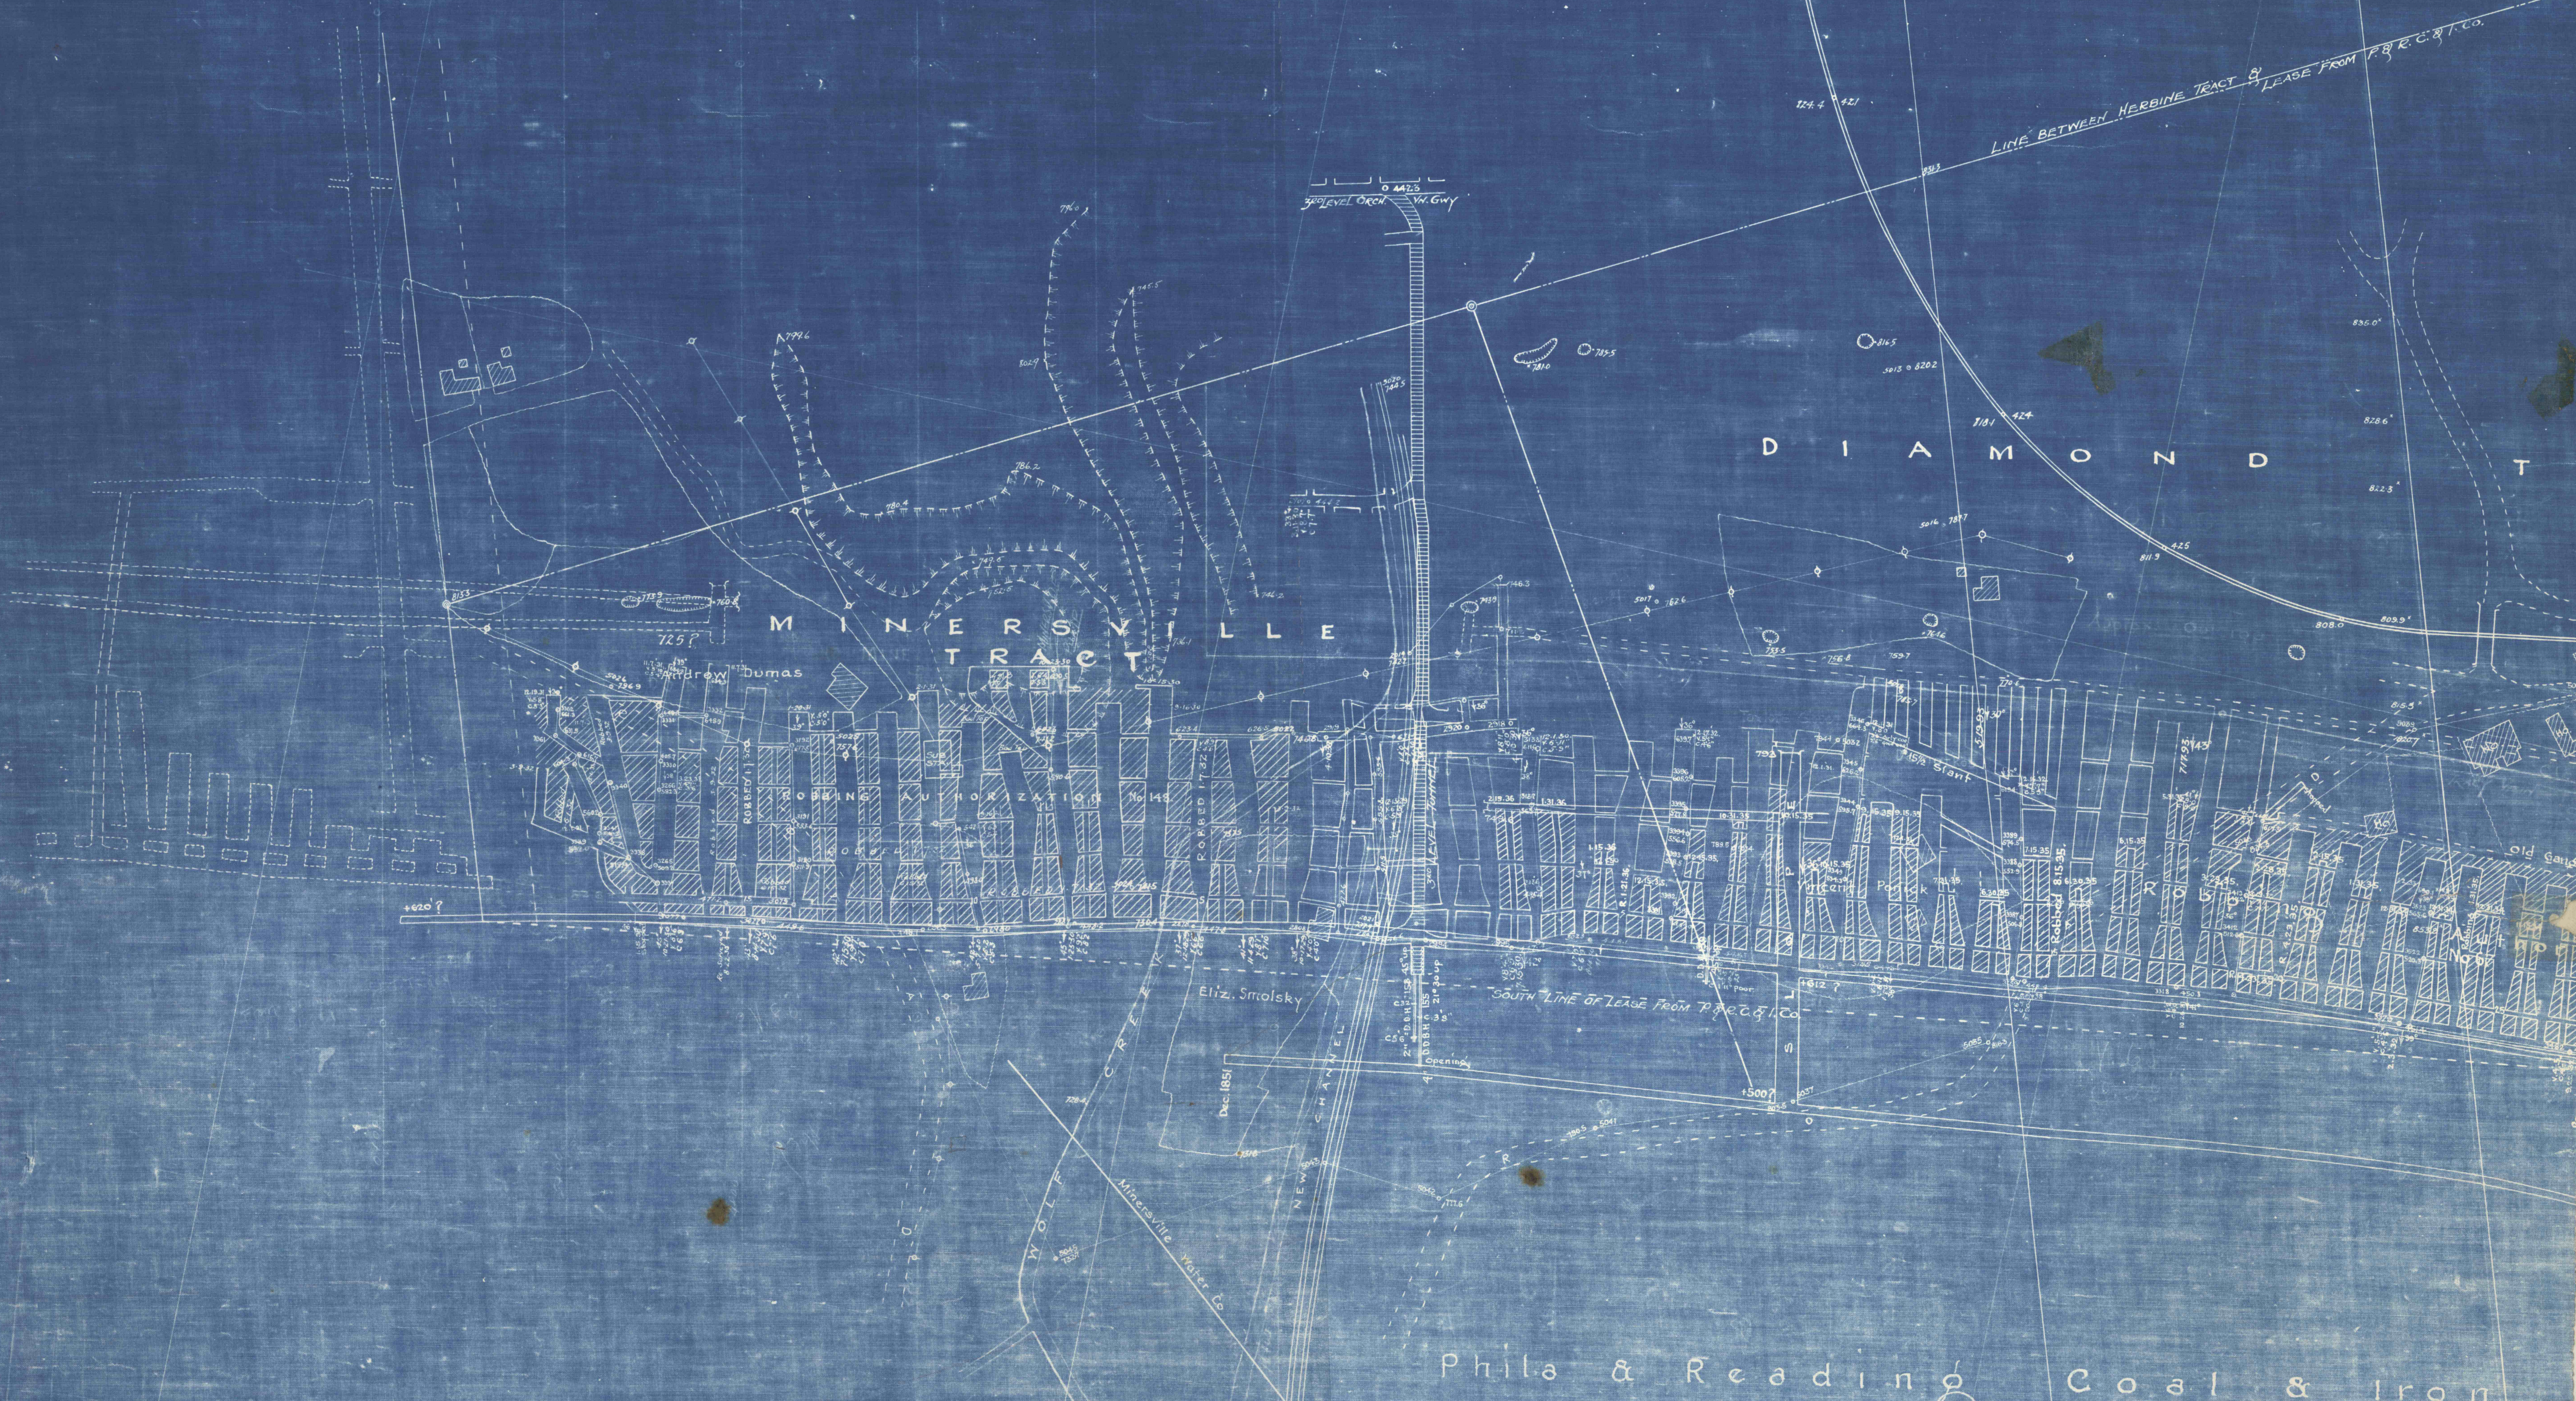

Phila & Reading Coal & Iron

Southern COAL FIELD.
OAK HILL Colliery. "TRACY..LITTLE TRACY Vein". 1"=100'.
CASS TWP, SCHUYLKILL COUNTY, PA. 15-W. SCHUYL. DISTRICT
READING ANTHRACITE COAL CO'S.



MF
MAR 10 1972

MF
MAR 10 1972