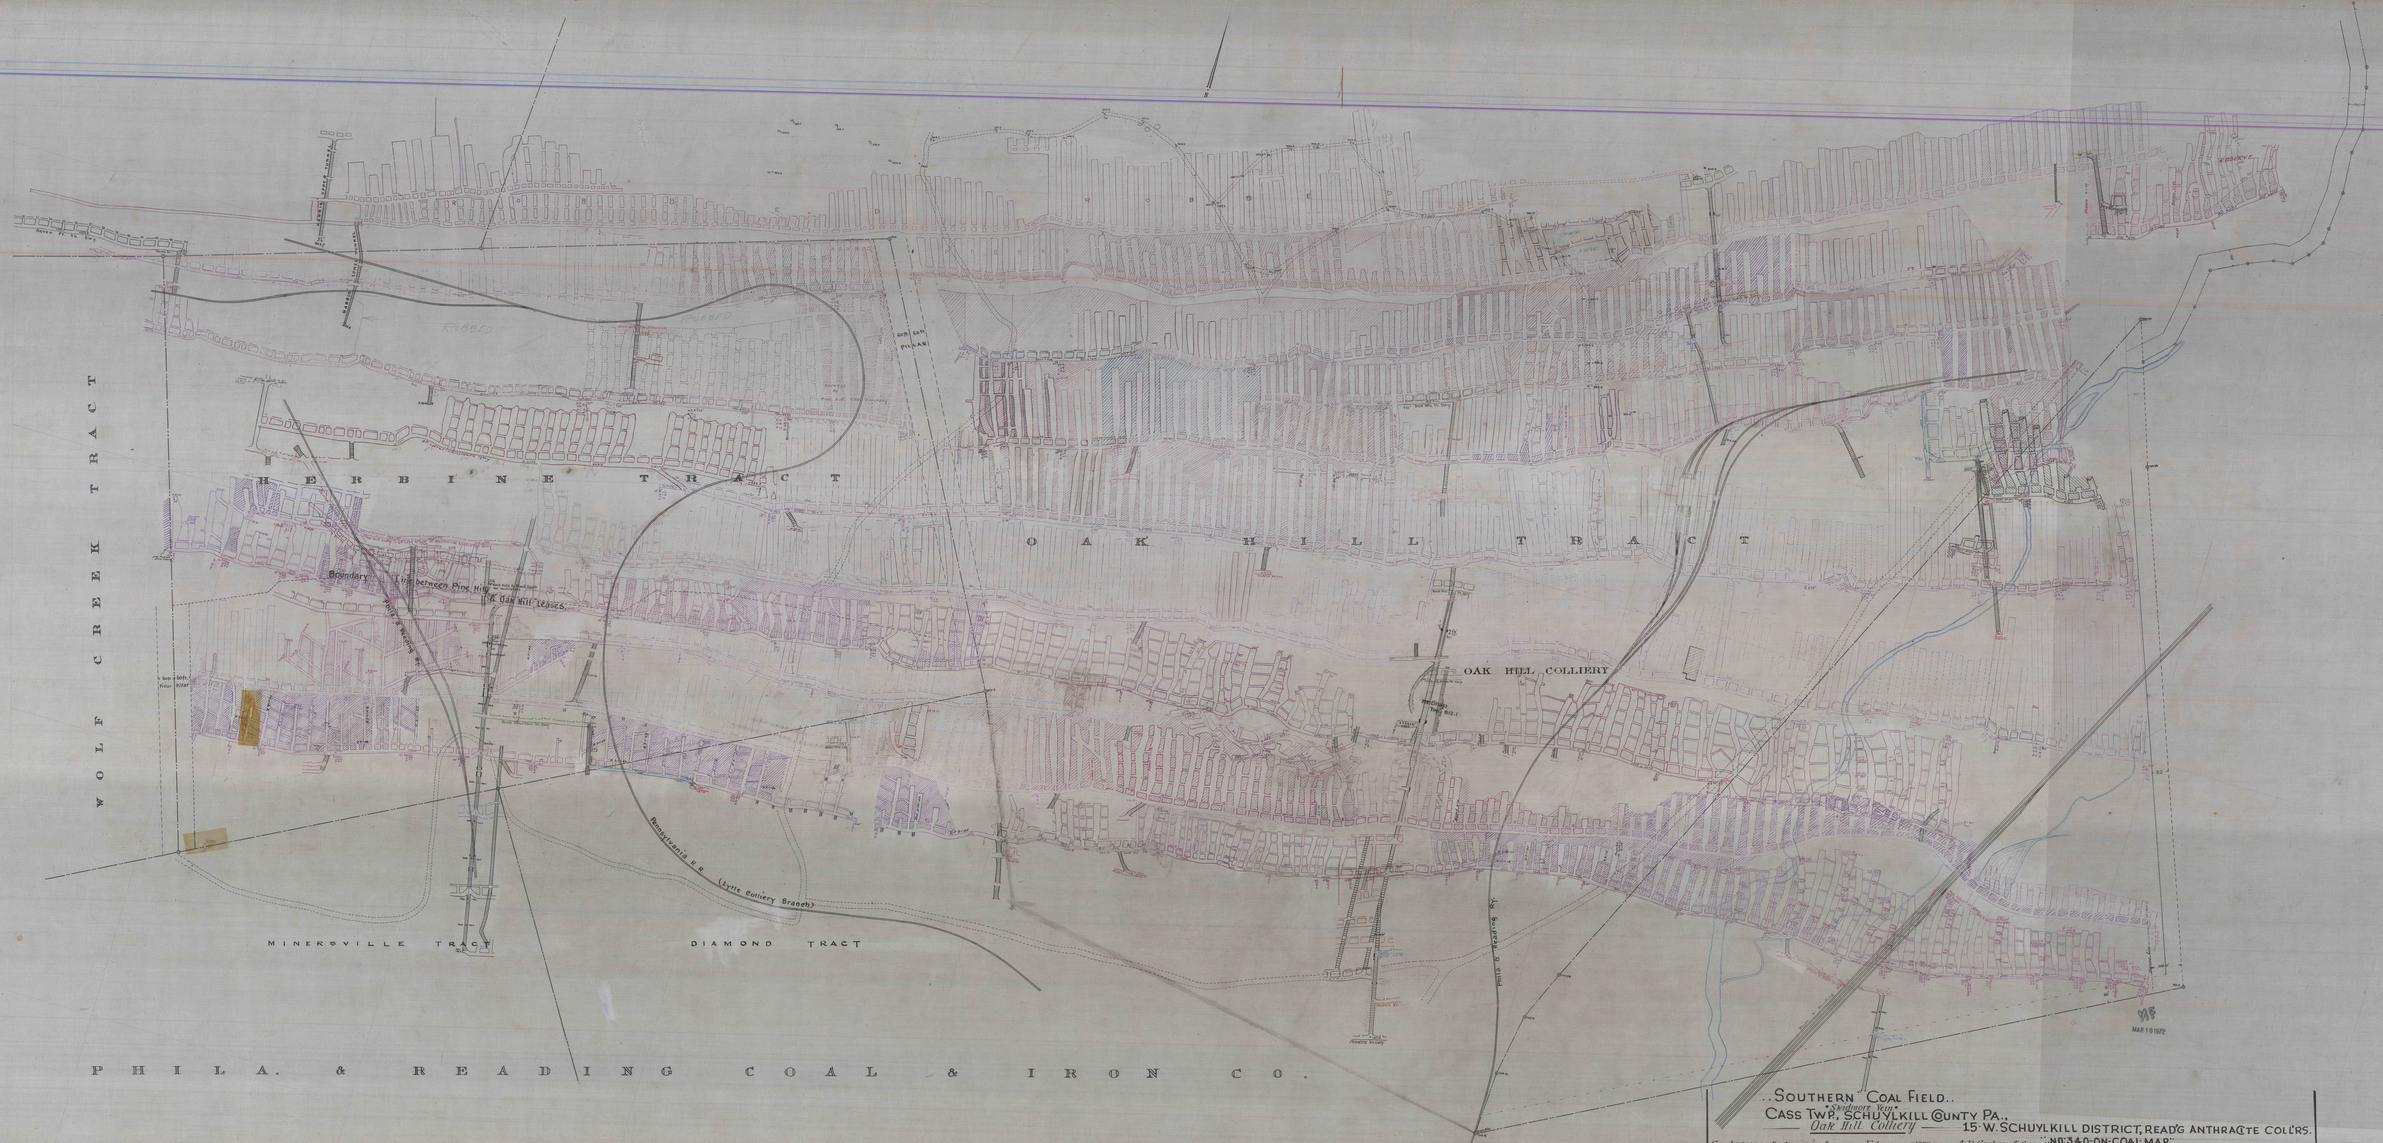

HERBINE TRACT
OAK HILL TRACT
WOLF CREEK TRACT
Boundary Line between Pine Hill & Oak Hill Leases
OAK HILL COLLIERY
Pennsylvania R.R. (Lytle Colliery Branch)
Phila & Reading R.R.
MINERSVILLE TRACT
DIAMOND TRACT
PHILA. & READING COAL & IRON CO.
MAR 10 1972

..SOUTHERN COAL FIELD..

•Skidmore Vein•

CASS TWP., SCHUYLKILL COUNTY PA.,

Oak Hill Colliery — 15·W. SCHUYLKILL DISTRICT, READ'G ANTHRACITE COLL'RS.

Scale: 100 feet per inch — *February 1909* — *A. B. Cochran & Son* Engineers ..NO:340-ON-COAL-MAP..