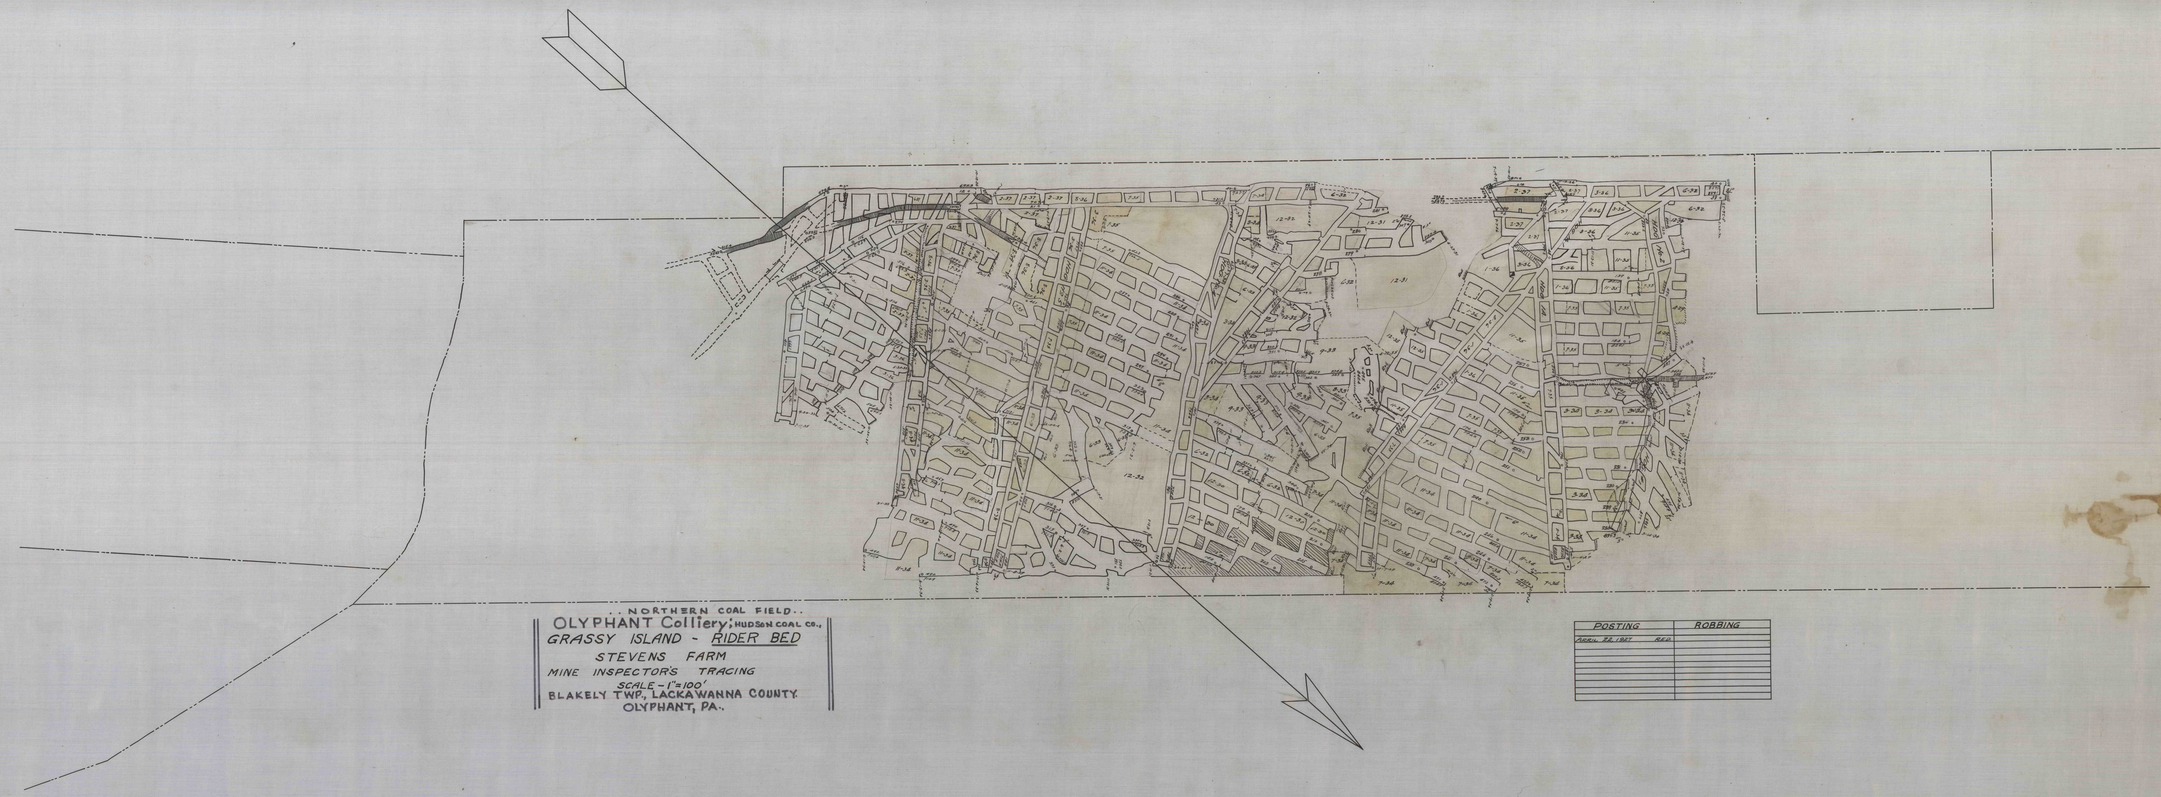

...NORTHERN COAL FIELD...

OLYPHANT Colliery; HUDSON COAL CO.,

GRASSY ISLAND - RIDER BED

STEVENS FARM

MINE INSPECTOR'S TRACING

SCALE - 1" = 100'

BLAKELY TWP., LACKAWANNA COUNTY

OLYPHANT, PA.

POSTING	ROBBING
APRIL 22, 1927	