


LACKAWANNA COAL CO. LTD.

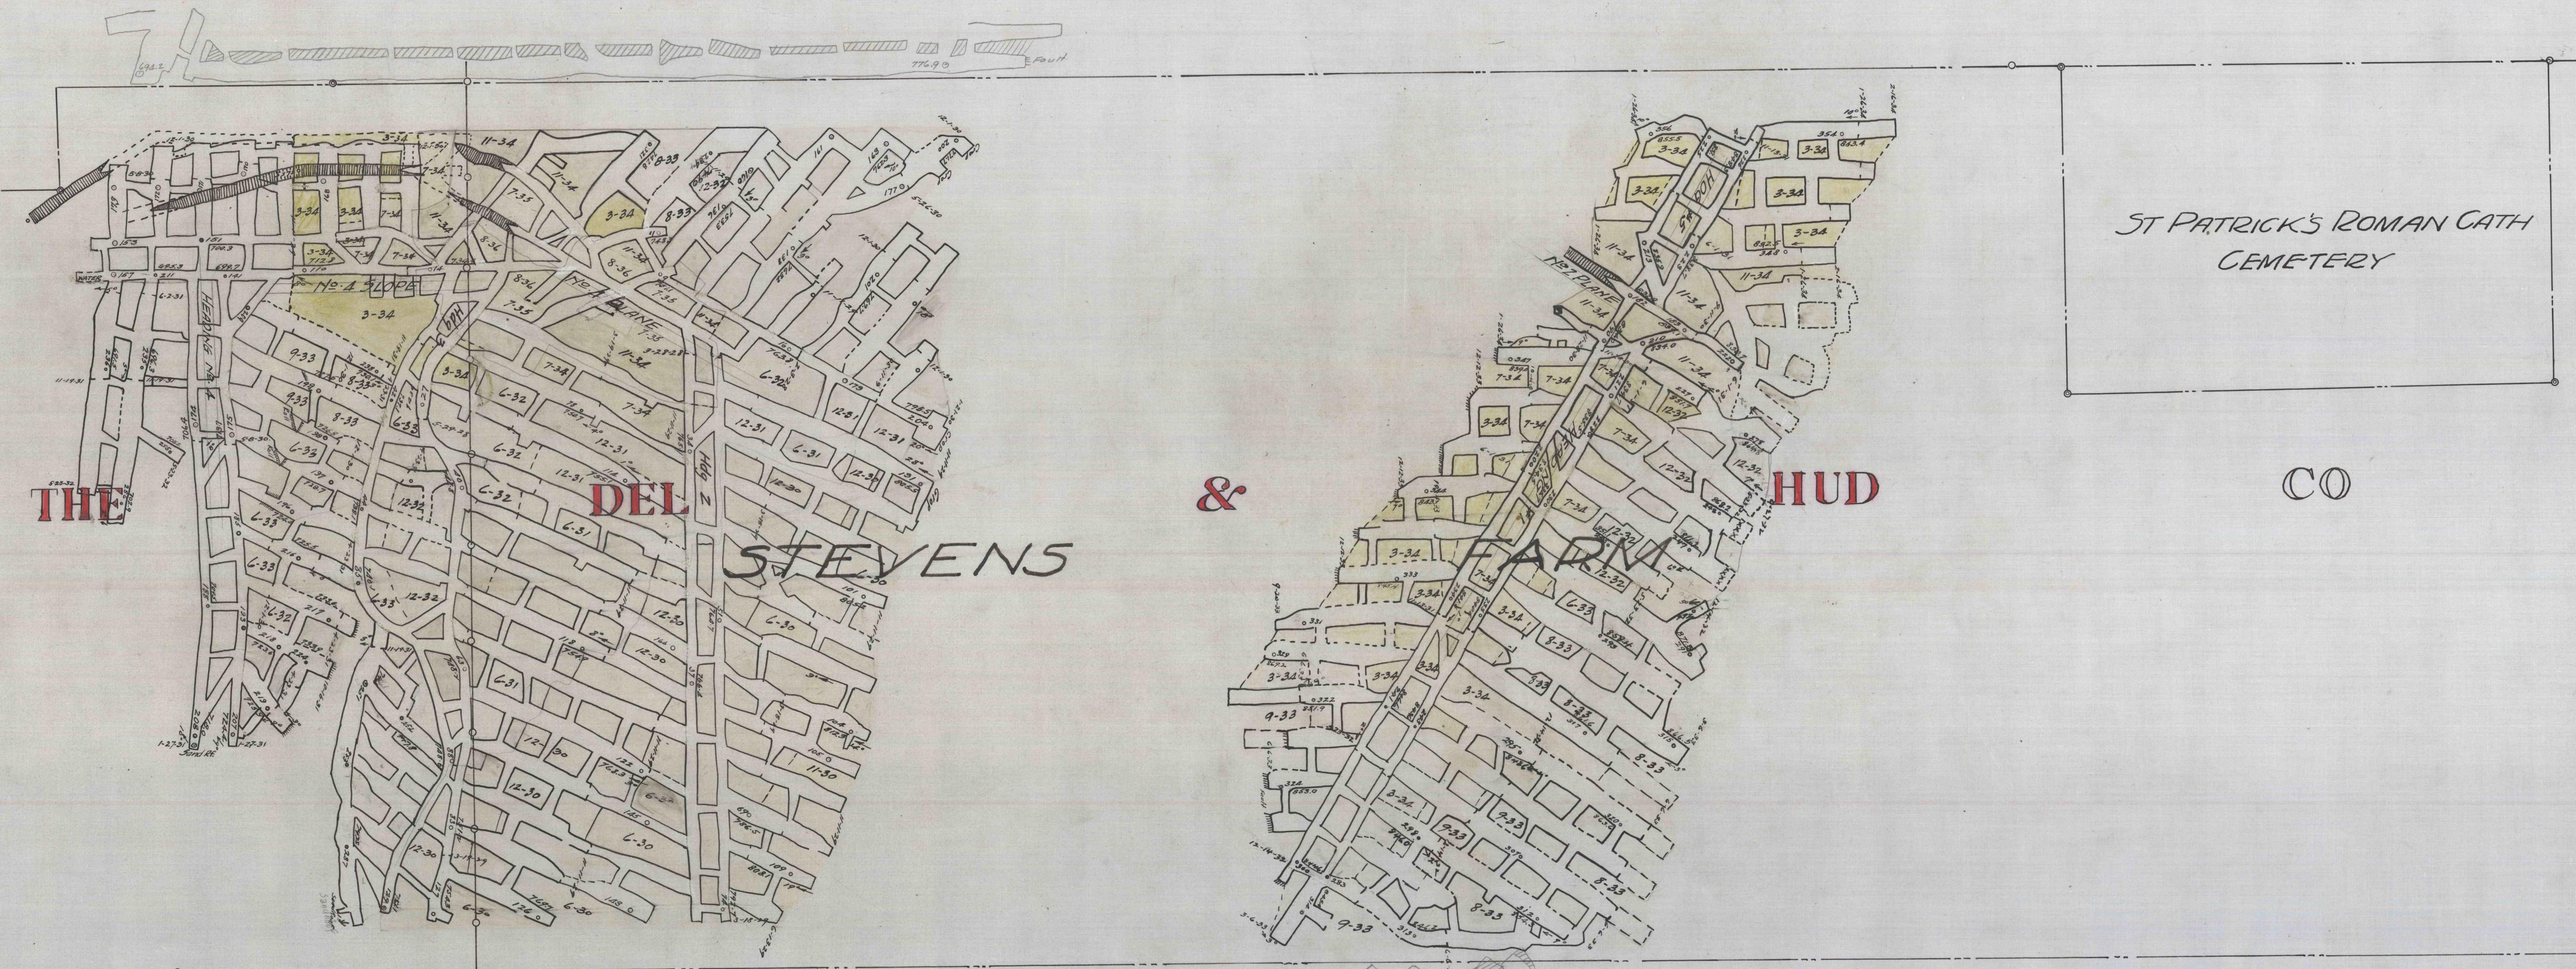

LACKAWANNA COAL CO. LTD.

..NORTHERN COAL FIELD.. OLYPHANT COLLIERY.. ROCK BED. 1"=100'.

BLAKELY Twp., Lackawanna County, Olyphant PA., HUDSON Coal Co., Grassy Island


