


PLAN OF SURFACE DETAILS
CENTRAL MINE FIRE
SCALE 1"=50'

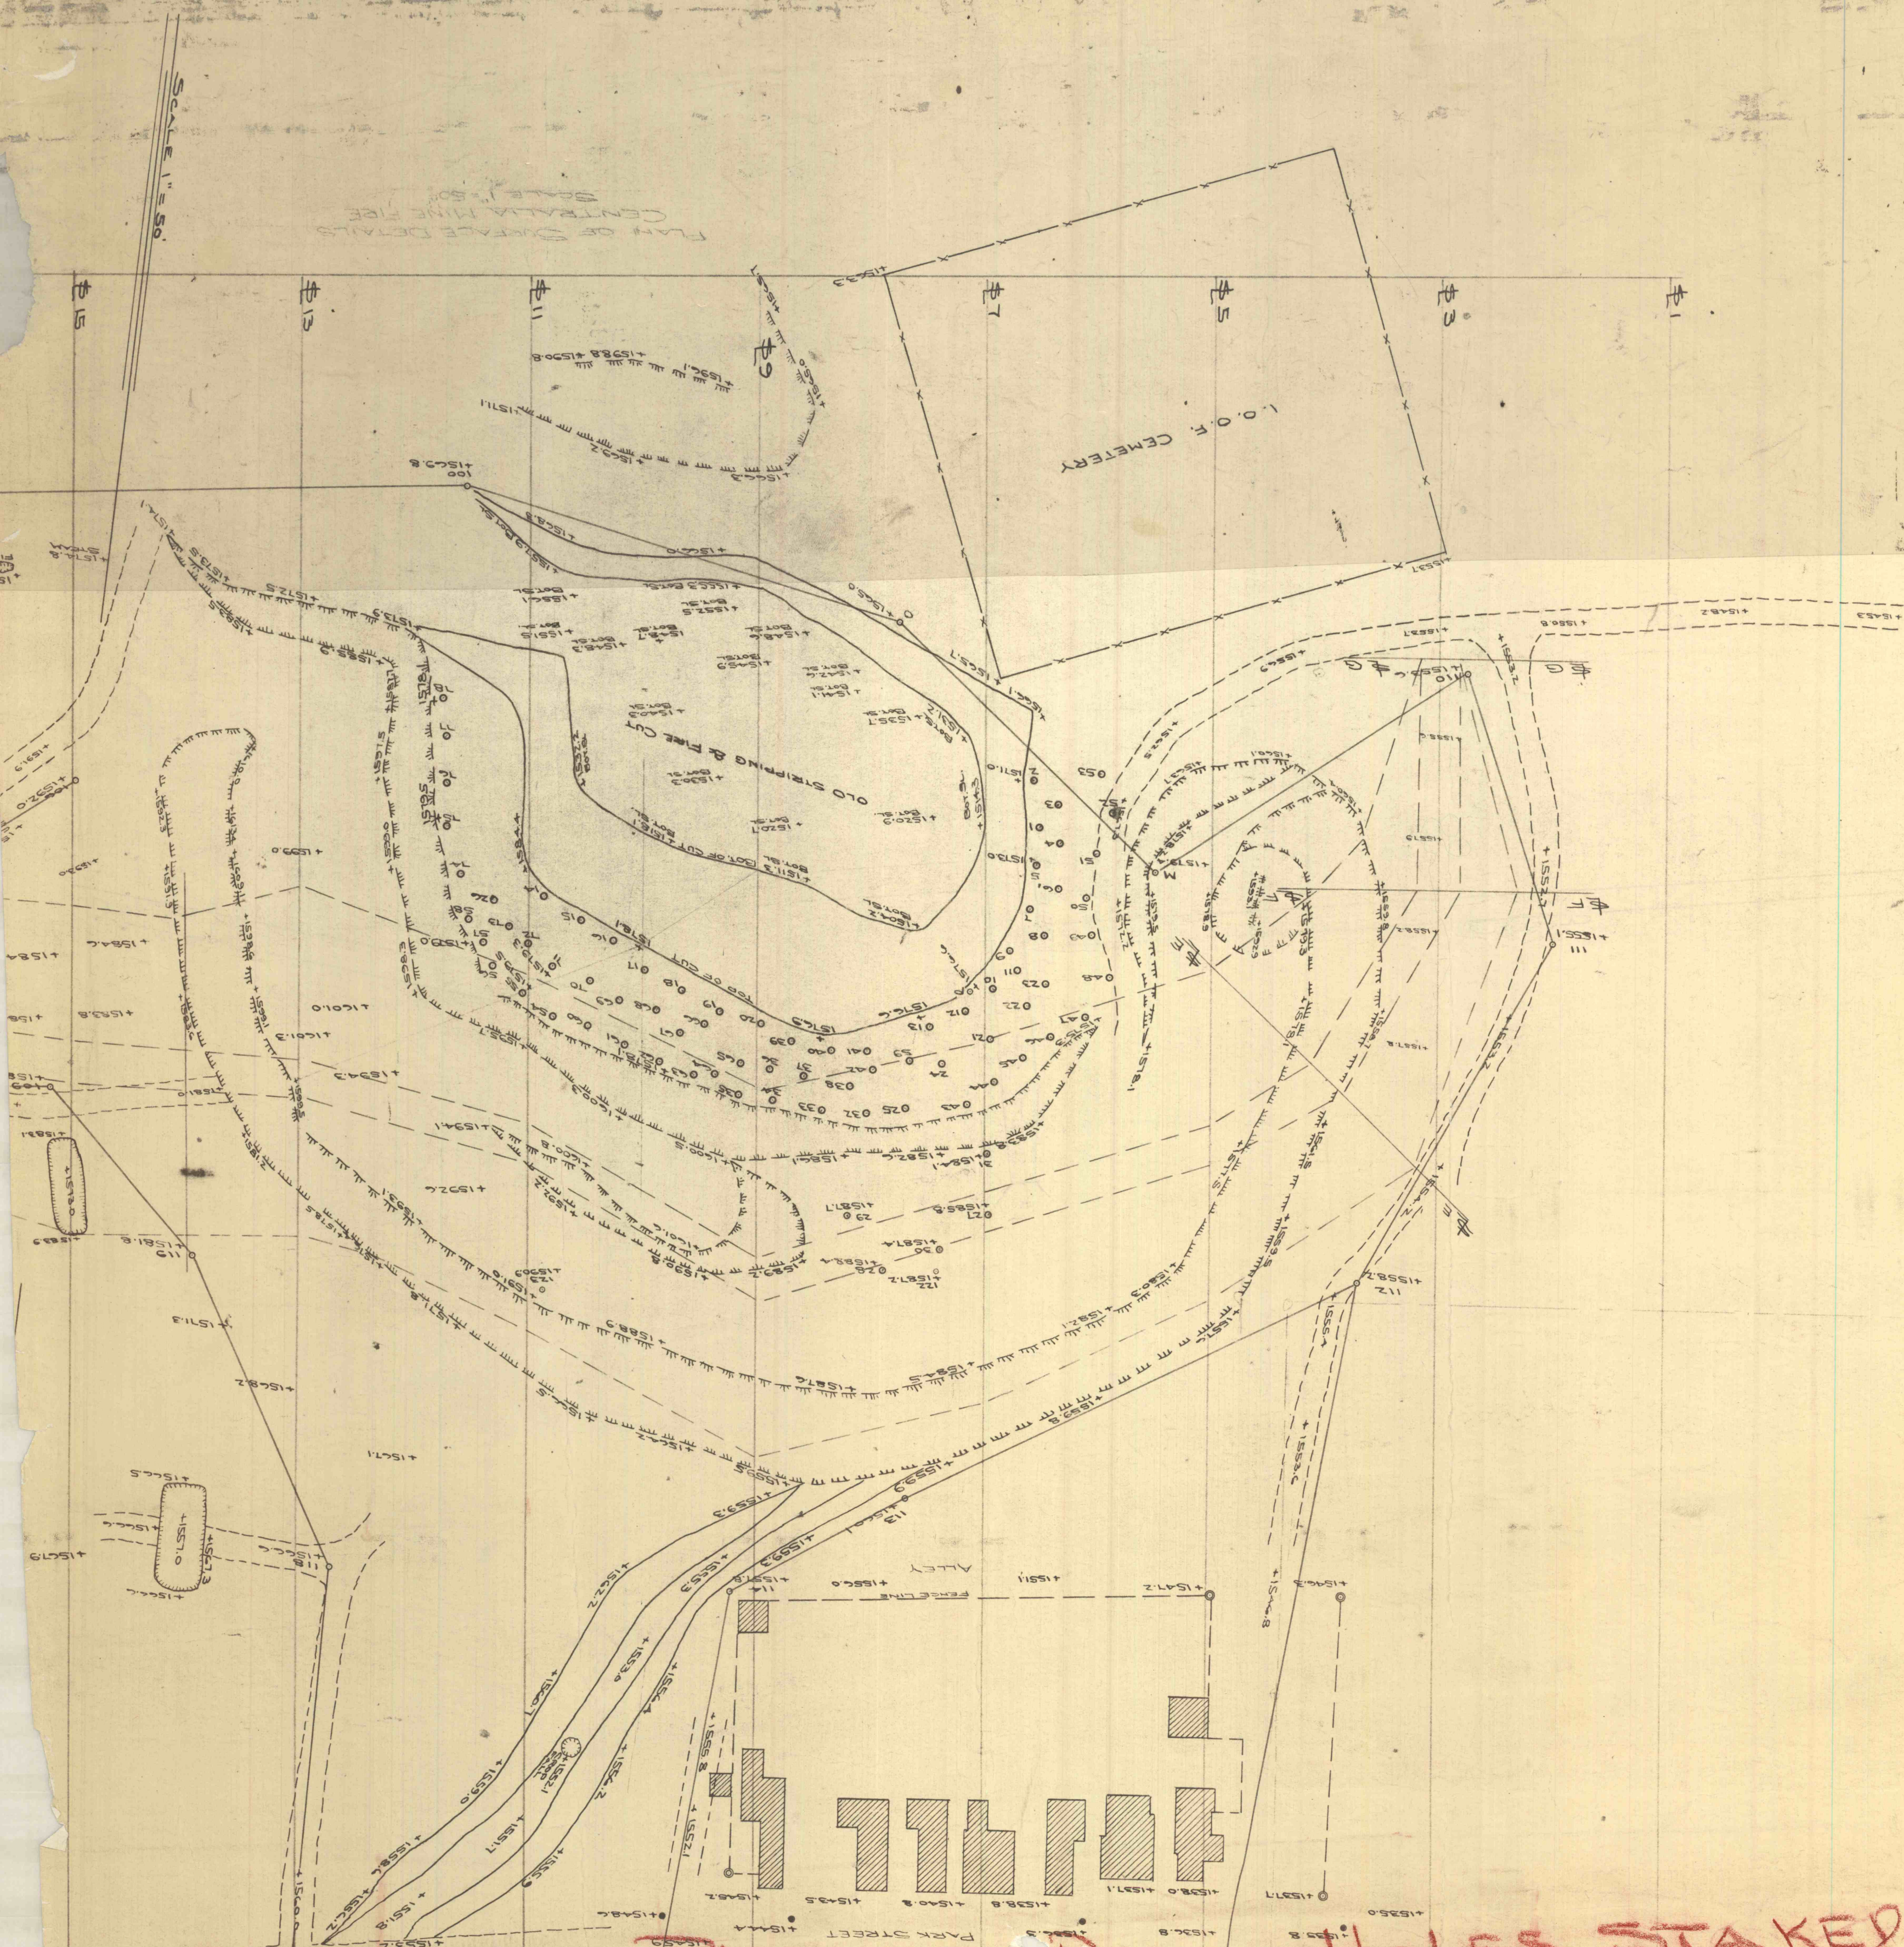

ORIGINAL PLAN OF DRILL HOLES STAKED OUT
